

WATER WELL RECORD Form WWC-5 KSA 82a-1212

1 LOCATION OF WATER WELL: County: Ellis Fraction NW 1/4 SW 1/4 NW 1/4 Section Number 3 Township Number T 14 S Range Number R 18 EW

Distance and direction from nearest town or city street address of well if located within city?

E of US Hwy 183 & N of Vine St., Hays


2 WATER WELL OWNER: The Dow Chemical Co.

RR#, St. Address, Box #: 3100 State Road

City, State, ZIP Code :Croydon, PA 19021

Board of Agriculture, Division of Water Resources Application Number:

3 LOCATE WELL'S LOCATION WITH AN "X" IN SECTION BOX:

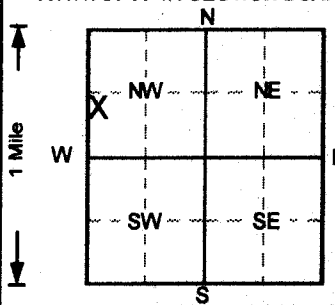

4 DEPTH OF COMPLETED WELL 43 ft ELEVATION:

Depth(s) Groundwater Encountered 1. . . . . ft 2. . . . . ft 3. . . . . ft

WELL'S STATIC WATER LEVEL . . . . . ft below land surface measured on mo/day/yr

Pump test data: Well water was NA ft after . . . . . hours pumping . . . . . gpm

Est. Yield NA gpm; Well water was . . . . . ft after . . . . . hours pumping . . . . . gpm

Bore Hole Diameter 8 in. to 43 ft. and . . . . . in. to . . . . . ft

WELL WATER TO BE USED AS: 5 Public water supply 8 Air conditioning 11 Injection well

1 Domestic 3 Feedlot 6 Oil field water supply 9 Dewatering 12 Other (Specify below)

2 Irrigation 4 Industrial 7 Lawn and garden only 10 Monitoring well

Was a chemical/bacteriological sample submitted to Department? Yes No; Water Well Disinfection? Yes No

5 TYPE OF BLANK CASING USED: 1 Steel 3 RMP (SR) 5 Wrought iron 8 Concrete tile CASING JOINTS: Glued Clamped

2 PVC 4 ABS 6 Asbestos-Cement 9 Other (specify below) Welded

Blank casing diameter .2 in. to .28 ft. Dia . in. to . ft. Dia . in. to . ft.

Casing height above land surface . . . . . in., weight . . . . . lbs./ft. Wall thickness or gauge No. . . . . Sch. 40

TYPE OF SCREEN OR PERFORATION MATERIAL 1 Steel 3 Stainless steel 5 Fiberglass 7 PVC 10 Asbestos-cement

2 Brass 4 Galvanized steel 6 Concrete tile 8 RMP (SR) 11 Other (specify)

SCREEN OR PERFORATION OPENINGS ARE: 1 Continuous slot 3 Mill slot 5 Gauzed wrapped 8 Saw cut 11 None (open hole)

2 Louvered shutter 4 Key punched 6 Wire wrapped 9 Drilled holes 10 Other (specify)

SCREEN-PERFORATED INTERVALS: From 28 ft to 43 ft, From . ft to . ft

GRAVEL PACK INTERVALS: From 26 ft to 43 ft, From . ft to . ft

6 GROUT MATERIAL: 1 Neat cement 2 Cement grout 3 Bentonite 4 Other

Grout intervals: From 1 ft to 26 ft, From 3 ft to . ft, From . ft to . ft

What is the nearest source of possible contamination: 1 Septic tank 4 Lateral lines 7 Pit privy 10 Livestock pens 14 Abandoned water well

2 Sewer lines 5 Cess pool 8 Sewage lagoon 11 Fuel storage 15 Oil well/Gas well

3 Watertight sewer lines 6 Seepage pit 9 Feedyard 12 Fertilizer storage 16 Other (specify below)

Direction from well? How many feet?

Table with columns FROM, TO, LITHOLOGIC LOG, FROM, TO, PLUGGING INTERVALS

0 5 Clay, silty, Dark Brown

5 15 Clay, silty, Brown

15 43 Silt, clayey, Lt. Brown

P3R, Flushmount

7 CONTRACTORS OR LANDOWNERS CERTIFICATION: This water well was (1) constructed, (2) reconstructed, or (3) plugged under my jurisdiction

and was completed on (mo/day/year) 6/8/2012 and this record is true to the best of my knowledge and belief.

Kansas Water Well Contractor's License No. 527 This Water Well Record was completed on (mo/day/yr) under the business name of GeoCore, Inc. by (signature) Dan Hill

INSTRUCTIONS: Use typewriter or ball point pen. PLEASE PRESS FIRMLY and PRINT clearly. Please fill in blanks, underline or circle the correct answers. Send top three copies to Kansas Department of Health and Environment, Bureau of Water, Topeka, Kansas 66620-0001. Telephone: 913-296-5545. Send one to WATER WELL OWNER and retain one for your records.

OFFICE USE ONLY

T

R

EW

SEC.

1/4

1/4

1/4