# WATER WELL PLUGGING RECORD Form WWC-5P KSA 82a-1212 ID NO. MW-2

| 1 LOCATION OF WATER WELL: | Fraction | Section Number | Township Number | Range Number |
|---|---|---|---|---|
| Ellis County | NE ¼ NE ¼ NW ¼ | 4 | 14 S | R 18 W |

Distance and direction from nearest town or city street address of well if located within city?
**Well was located at 233 E 8th St., Hays, KS**

**2 WATER WELL OWNER:**
**KDHE**
RR#, St. Address, Box #:
**1000 SW Jackson**
City, State ZIP Code:
**Topeka, KS 66612**

**Global Positioning Systems** (decimal degrees, min. of 4 digits
Latitude: _____
Longitude: _____
Elevation: _____
Datum: _____
Data Collection Method:

**3 MARK WELL'S LOCATION WITH AN "X" IN SECTION BOX:**

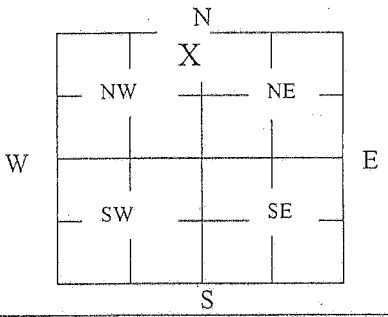


**4 DEPTH OF WELL** 25.67 ft.

WELL'S STATIC WATER LEVEL 21.68 ft

WELL WAS USED AS: X

1 Domestic
2 Irrigation
3 Feedlot
4 Industrial
5 Public Water Supply
6 Oil Field Water Supply
7 Domestic (Lawn & Garden)
8 Air Conditioning
9 Dewatering
10 Monitoring
11 Injection Well
12 Other _____

Was a chemical/bacteriological sample submitted to Department? Yes_____ No _x_____

**5 TYPE OF BLANK CASING USED:**
1 Steel
2 PVC
3 RMP (SR)
4 ABS
5 Wrought
6 Asbestos-Cement
7 Fiberglass
8 Concrete Tile
9 Other (Specify below) _____

Blank casing diameter 2 in. Was casing pulled? Yes x No _____ If yes, how much 3'
Casing height above or below land surface 36 in.

**6 GROUT PLUG MATERIAL:** 1 Neat cement 2 Cement grout 3 Bentonite 4 Other _ Soil_____

Grout Plug Intervals: From2 0 ft. to 0.5 ft., From4 0.5 ft. to 3.5 ft., From3 3.5 to 25.67 ft.

What is the nearest source of possible contamination:
1 Septic tank
2 Sewer lines
3 Watertight sewer lines
4 Lateral lines
5 Cess pool
6 Seepage pit
7 Pit privy
8 Sewage lagoon
9 Feedyard
10 Livestock pens
11 Fuel Storage
12 Fertilizer storage
13 Insecticide storage
14 Abandoned water well
15 Oil well/Gas well
16 Other (specify below)
_Contaminated Site_____

Direction from well? _____
How many feet? _____

| FROM | TO | PLUGGING MATERIALS | FROM | TO | PLUGGING MATERIALS |
|---|---|---|---|---|---|
| 0' | 0.5' | Concrete | | | |
| 0.5' | 3.5' | Compacted Soil | | | |
| 3.5' | 25.67' | Bentonite Chips | | | |
| | | | | | |
| | | | | | |
| | | | | | |
| | | | | | |

**7 CONTRACTOR'S OR LANDOWNER'S CERTIFICATION:** This water well was plugged under my jurisdiction and was completed on (mo/day/year) 12/04/13 and this record is true to the best of my knowledge and belief. Kansas Water Well Contractor's License No. 585. This Water Well Record was completed on (mo/day/year) 12/10/13 under the business name of Associated Environmental, Inc. by (signature) [signature]

**INSTRUCTIONS:** Use typewriter or ballpoint pen. Please press firmly and print clearly. Please fill in blanks, underline or circle the correct answers. Send top three copies to Kansas Department of Health and Environment, Bureau of Water, Geology Section, 1000 SW Jackson St., Ste. 420, Topeka, Kansas 66612-1367. Telephone: 785/296-5522. Send one to Water Well Owner and retain one for your records. Visit us at http://www.kdheks.gov/waterwell/index.html.

RECEIVED
KS GEO SURVEY