


<b>1 LOCATION OF WATER WELL:</b> County: <u>Ellis</u>	Fraction <u>¼NW ¼ SW ¼ NW ¼</u>	Section Number <u>3</u>	Township Number <u>T 14 S</u>	Range Number <u>18</u> <input type="checkbox"/> E <input checked="" type="checkbox"/> W
--	------------------------------------	----------------------------	----------------------------------	--

Street/Rural Address of Well Location; if unknown, distance & direction from nearest town or intersection: If at owner's address, check here <input type="checkbox"/> 1002 Vine Street, Hays	<b>Global Positioning Systems (GPS) information:</b> Latitude: _____ (in decimal degrees) Longitude: _____ (in decimal degrees) Elevation: _____ Horizontal Datum: <input type="checkbox"/> WGS84, <input type="checkbox"/> NAD83, <input type="checkbox"/> NAD27 Collection Method: _____
--	---

<b>2 WATER WELL OWNER:</b> City of Hays Service Dept. RR#, St. Address, Box #: P.O. Box 490 City, State ZIP Code: Hays, KS 67601	GPS unit (Make/Model): _____ <input type="checkbox"/> Digital Map/Photo, <input type="checkbox"/> Topographic Map, <input type="checkbox"/> Land Survey Est. Accuracy: <input type="checkbox"/> < 3 m, <input type="checkbox"/> 3-5 m, <input type="checkbox"/> 5-15 m, <input type="checkbox"/> > 15 m
--	---

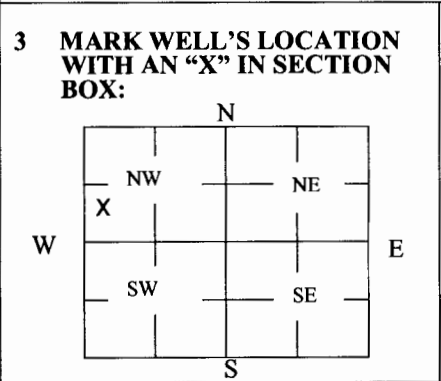

**4 DEPTH OF WELL** 21.65 ft.  
**WELL'S STATIC WATER LEVEL** DRY ft.  
**WELL WAS USED AS:**

<input type="checkbox"/> Domestic	<input type="checkbox"/> Public Water Supply	<input type="checkbox"/> Dewatering
<input type="checkbox"/> Irrigation	<input type="checkbox"/> Oil Field Water Supply	<input type="checkbox"/> Monitoring
<input type="checkbox"/> Feedlot	<input type="checkbox"/> Domestic (Lawn & Garden)	<input type="checkbox"/> Injection Well
<input type="checkbox"/> Industrial	<input type="checkbox"/> Air Conditioning	<input checked="" type="checkbox"/> Other <u>Soil Vapor Extraction SVE-1</u>

Was a chemical/bacteriological sample submitted to Department? Yes  No

**5 TYPE OF BLANK CASING USED:**

<input type="checkbox"/> Steel	<input type="checkbox"/> RMP (SR)	<input type="checkbox"/> Wrought	<input type="checkbox"/> Fiberglass	<input type="checkbox"/> Other (Specify below) _____
<input checked="" type="checkbox"/> PVC	<input type="checkbox"/> ABS	<input type="checkbox"/> Asbestos-Cement	<input type="checkbox"/> Concrete Tile	

Blank casing diameter 4 in. Was casing pulled? Yes  No  If yes, how much 3'  
 Casing height above or below land surface 36 in.

**6 GROUT PLUG MATERIAL:**  Neat cement  Cement grout  Bentonite  Other \_\_\_\_\_

Grout Plug Intervals: From 3 ft. to 21.65 ft., From \_\_\_\_\_ ft. to \_\_\_\_\_ ft., From \_\_\_\_\_ ft. to \_\_\_\_\_ ft.

What is the nearest source of possible contamination:

<input type="checkbox"/> Septic tank	<input type="checkbox"/> Seepage pit	<input checked="" type="checkbox"/> Fuel storage	<input type="checkbox"/> Other (specify below) _____
<input type="checkbox"/> Sewer lines	<input type="checkbox"/> Pit privy	<input type="checkbox"/> Fertilizer storage	
<input type="checkbox"/> Watertight sewer lines	<input type="checkbox"/> Sewage lagoon	<input type="checkbox"/> Insecticide storage	
<input type="checkbox"/> Lateral lines	<input type="checkbox"/> Feedyard	<input type="checkbox"/> Abandoned water well	Direction from well? _____
<input type="checkbox"/> Cess pool	<input type="checkbox"/> Livestock pens	<input type="checkbox"/> Oil well/Gas well	How many feet? _____

FROM	TO	PLUGGING MATERIALS	FROM	TO	PLUGGING MATERIALS
0	3	Native soil			
3	21.65	Bentonite hole plug			

**7 CONTRACTOR'S OR LANDOWNER'S CERTIFICATION:** This water well was plugged under my jurisdiction and was completed on (mo/day/year) 4-1-16 and this record is true to the best of my knowledge and belief. Kansas Water Well Contractor's License No. 735. This Water Well Record was completed on (mo/day/year) 4-14-16 under the business name of MILCO Environmental Services, Inc. by (signature) *[Signature]*

Send one white copy to Kansas Department of Health & Environment, Geology Section, 1000 SW Jackson Street, Ste. 420, Topeka, KS 66612-1367. Send one copy to WATER WELL OWNER and retain one for your records.  
 Visit us at <http://www.kdheks.gov/waterwell/index.html> Telephone 785-296-5524.



# MILCO

**Environmental Services, Inc.**

April 29, 2016

320 West 4th Street  
Colby, KS 67701  
Tel: 785-460-1956  
Fax: 785-460-4220  
www.milcoinc.com

Kansas Department of Health and Environment  
Bureau of Water - GWTS  
1000 SW Jackson St, Ste 420  
Topeka, KS 66612-1367

RE: Hoxie Stop 2 Shop  
KDHE Project Code U6-090-14793  
MILCO Project No. M259-P8-01

City of Hays Service Center  
KDHE Project Code U6-026-00771  
MILCO Project No. M273-G1-01

Halliburton Energy Services  
KDHE Project Code U1-095-11019  
MILCO Project No. M435-P2-02

Dear Sir or Madam:

Please find enclosed five (5) Water Well Records for the Hoxie Stop 2 Shop site. The wells were constructed by RMD Drilling and Well Service on April 1 and April 4, 2016.

Please find enclosed eight (8) Water Well Plugging Records for the City of Hays Service Center site. The wells were abandoned by MILCO on April 1, 2016.

Please find enclosed three (3) Water Well Records and four (4) Water Well Plugging Records for the Halliburton Energy Services site. The wells were constructed and plugged by Woofter Pump and Well on February 12, 2016.

A check for \$40.00 is enclosed for the 5 Hoxie Stop 2 Shop and 3 Halliburton Energy WWC5s. If you need any additional information, please don't hesitate to contact us.

Respectfully submitted,  
**MILCO Environmental Services, Inc.**



Leah MacNeill

Enclosures

RECEIVED

MAY 09 2016

BUREAU OF WATER