


1 LOCATION OF WATER WELL: Fraction 1/4 NW 1/4 SW 1/4 NW 1/4 Section Number 3 Township Number T 14 S Range Number 18 E W
 County: Ellis

Street/Rural Address of Well Location; if unknown, distance & direction from nearest town or intersection: If at owner's address, check here 1002 Vine Street, Hays

Global Positioning Systems (GPS) information:
 Latitude: _____ (in decimal degrees)
 Longitude: _____ (in decimal degrees)
 Elevation: _____
 Horizontal Datum: WGS84, NAD83, NAD27
 Collection Method: _____

2 WATER WELL OWNER: City of Hays Service Dept.
 RR#, St. Address, Box #: P.O. Box 490
 City, State ZIP Code: Hays, KS 67601

GPS unit (Make/Model): _____
 Digital Map/Photo, Topographic Map, Land Survey
 Est. Accuracy: < 3 m, 3-5 m, 5-15 m, > 15 m

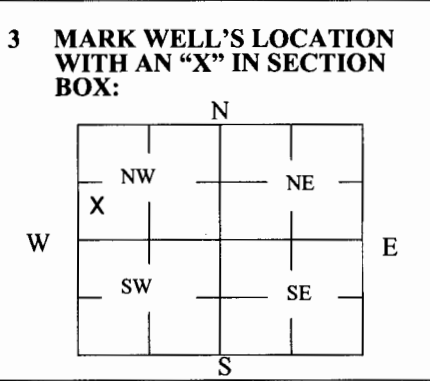

4 DEPTH OF WELL 33.85 ft.
 WELL'S STATIC WATER LEVEL 24.11 ft.
 WELL WAS USED AS:

Domestic Public Water Supply Dewatering
 Irrigation Oil Field Water Supply Monitoring
 Feedlot Domestic (Lawn & Garden) Injection Well AS-4
 Industrial Air Conditioning Other _____

Was a chemical/bacteriological sample submitted to Department? Yes No

5 TYPE OF BLANK CASING USED:

Steel RMP (SR) Wrought Fiberglass Other (Specify below) _____
 PVC ABS Asbestos-Cement Concrete Tile

Blank casing diameter 2 in. Was casing pulled? Yes No If yes, how much 3'
 Casing height above or below land surface 36 in.

6 GROUT PLUG MATERIAL: Neat cement Cement grout Bentonite Other _____

Grout Plug Intervals: From 3 ft. to 33.85 ft., From _____ ft. to _____ ft., From _____ ft. to _____ ft.

What is the nearest source of possible contamination:

Septic tank Seepage pit Fuel storage Other (specify below) _____
 Sewer lines Pit privy Fertilizer storage _____
 Watertight sewer lines Sewage lagoon Insecticide storage _____
 Lateral lines Feedyard Abandoned water well Direction from well? _____
 Cess pool Livestock pens Oil well/Gas well How many feet? _____

FROM	TO	PLUGGING MATERIALS	FROM	TO	PLUGGING MATERIALS
0	3	Native soil			
3	33.85	Bentonite hole plug			

7 CONTRACTOR'S OR LANDOWNER'S CERTIFICATION: This water well was plugged under my jurisdiction and was completed on (mo/day/year) 4-1-16 and this record is true to the best of my knowledge and belief. Kansas Water Well Contractor's License No. 735. This Water Well Record was completed on (mo/day/year) 4-14-16 under the business name of MILCO Environmental Services, Inc. by (signature)

Send one white copy to Kansas Department of Health & Environment, Geology Section, 1000 SW Jackson Street, Ste. 420, Topeka, KS 66612-1367. Send one copy to WATER WELL OWNER and retain one for your records.
 Visit us at <http://www.kdheks.gov/waterwell/index.html> Telephone 785-296-5524.



MILCO

Environmental Services, Inc.

April 29, 2016

320 West 4th Street
Colby, KS 67701
Tel: 785-460-1956
Fax: 785-460-4220
www.milcoinc.com

Kansas Department of Health and Environment
Bureau of Water - GWTS
1000 SW Jackson St, Ste 420
Topeka, KS 66612-1367

RE: Hoxie Stop 2 Shop
KDHE Project Code U6-090-14793
MILCO Project No. M259-P8-01

City of Hays Service Center
KDHE Project Code U6-026-00771
MILCO Project No. M273-G1-01

Halliburton Energy Services
KDHE Project Code U1-095-11019
MILCO Project No. M435-P2-02

Dear Sir or Madam:

Please find enclosed five (5) Water Well Records for the Hoxie Stop 2 Shop site. The wells were constructed by RMD Drilling and Well Service on April 1 and April 4, 2016.

Please find enclosed eight (8) Water Well Plugging Records for the City of Hays Service Center site. The wells were abandoned by MILCO on April 1, 2016.

Please find enclosed three (3) Water Well Records and four (4) Water Well Plugging Records for the Halliburton Energy Services site. The wells were constructed and plugged by Woofter Pump and Well on February 12, 2016.

A check for \$40.00 is enclosed for the 5 Hoxie Stop 2 Shop and 3 Halliburton Energy WWC5s. If you need any additional information, please don't hesitate to contact us.

Respectfully submitted,
MILCO Environmental Services, Inc.



Leah MacNeill

Enclosures

RECEIVED

MAY 09 2016

BUREAU OF WATER