

**WATER WELL PLUGGING RECORD Form WWC-5P**

KSA 82a-1212

ID NO.


IW-9

|   |                              |                     |                           |   |
|---|------------------------------|---------------------|---------------------------|---|
| <b>1 LOCATION OF WATER WELL:</b><br>County: Ellis | Fraction<br>¼ SE ¼ SE ¼ NE ¼ | Section Number<br>4 | Township Number<br>T 14 S | Range Number<br>18 <input type="checkbox"/> E <input checked="" type="checkbox"/> W |
|---|------------------------------|---------------------|---------------------------|---|

Street/Rural Address of Well Location; if unknown, distance & direction from nearest town or intersection: If at owner's address, check here  8th & Vine St, NW corner

**Global Positioning Systems (GPS) information:**  
 Latitude: \_\_\_\_\_ (in decimal degrees)  
 Longitude: \_\_\_\_\_ (in decimal degrees)  
 Elevation: \_\_\_\_\_  
 Horizontal Datum:  WGS84,  NAD83,  NAD27  
 Collection Method:  
 GPS unit (Make/Model: \_\_\_\_\_)  
 Digital Map/Photo,  Topographic Map,  Land Survey  
 Est. Accuracy:  < 3 m,  3-5 m,  5-15 m,  > 15 m

**2 WATER WELL OWNER:** Home Oil  
 RR#, St. Address, Box #: P.O. Box 673  
 City, State ZIP Code: Hays, KS

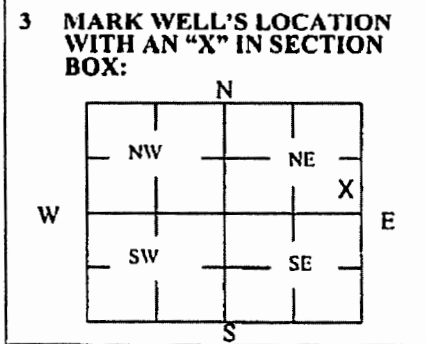

**4 DEPTH OF WELL** 34.55 ft.  
**WELL'S STATIC WATER LEVEL** 18.46 ft  
**WELL WAS USED AS:**  
 Domestic Irrigation     Public Water Supply     Dewatering  
 Feedlot     Oil Field Water Supply     Monitoring IW-9  
 Industrial     Domestic (Lawn & Garden)     Injection Well  
 Air Conditioning     Other \_\_\_\_\_  
 Was a chemical/bacteriological sample submitted to Department? Yes  No

**5 TYPE OF BLANK CASING USED:**

Steel     RMP (SR)     Wrought     Fiberglass     Other (Specify below)  
 PVC     ABS     Asbestos-Cement     Concrete Tile

Blank casing diameter 2 in. Was casing pulled? Yes  No  If yes, how much 12'  
 Casing height above or below land surface -24 in.

**6 GROUT PLUG MATERIAL:**  Neat cement     Cement grout     Bentonite     Other \_\_\_\_\_

Grout Plug Intervals: From 3 ft. to 34.55 ft., From \_\_\_\_\_ ft. to \_\_\_\_\_ ft., From \_\_\_\_\_ ft. to \_\_\_\_\_ ft.

What is the nearest source of possible contamination:  
 Septic tank     Seepage pit     Fuel storage     Other (specify below)  
 Sewer lines     Pit privy     Fertilizer storage  
 Watertight sewer lines     Sewage lagoon     Insecticide storage  
 Lateral lines     Feedyard     Abandoned water well    Direction from well? \_\_\_\_\_  
 Cess pool     Livestock pens     Oil well/Gas well    How many feet? \_\_\_\_\_

| FROM | TO    | PLUGGING MATERIALS | FROM | TO | PLUGGING MATERIALS |
|------|-------|--------------------|------|----|--------------------|
| 0    | 0.5   | Concrete           |      |    |                    |
| 0.5  | 3     | Native Soil        |      |    |                    |
| 3    | 34.55 | Bentonite Grout    |      |    |                    |
|      |       |                    |      |    |                    |
|      |       |                    |      |    |                    |
|      |       |                    |      |    |                    |

**7 CONTRACTOR'S OR LANDOWNER'S CERTIFICATION:** This water well was plugged under my jurisdiction and was completed on (mo/day/year) 11/28/18 and this record is true to the best of my knowledge and belief. Kansas Water Well Contractor's License No. 735. This Water Well Record was completed on (mo/day/year) 12/21/18 under the business name of MILCO Environmental Services, Inc. by (signature) *[Signature]*

Send one white copy to Kansas Department of Health & Environment, Geology Section, 1000 SW Jackson Street, Ste. 420, Topeka, KS 66612-1367. Send one copy to WATER WELL OWNER and retain one for your records.  
 Visit us at <http://www.kdheks.gov/waterwell/index.html> Telephone 785-296-5524.