

WATER WELL PLUGGING RECORD Form WWC-5P KSA 82a-1212 ID NO.

00270502


| | | | | |
|--|--|----------------------------|----------------------------------|--|
| 1 LOCATION OF WATER WELL: County: <u>Ellis</u> | Fraction <u>NW 1/4 SW 1/4 SW 1/4 SW 1/4</u> | Section Number <u>2</u> | Township Number <u>14 T S</u> | Range Number <u>18</u> <input type="checkbox"/> E <input checked="" type="checkbox"/> W |
|--|--|----------------------------|----------------------------------|--|

Street/Rural Address of Well Location; if unknown, distance & direction from nearest town or intersection: If at owner's address, check here Karst Water Well (formerly) 2070 E. 8th St, Hays, KS 67601 (currently Roofmasters)

Global Positioning Systems (GPS) information:
 Latitude: 38.85812 (in decimal degrees)
 Longitude: -099.29859 (in decimal degrees)
 Elevation: 1997'
 Horizontal Datum: WGS84, NAD83, NAD27
 Collection Method:

2 WATER WELL OWNER:
 RR#, St. Address, Box #:
 City, State ZIP Code:

GPS unit (Make/Model): _____
 Digital Map/Photo, Topographic Map, Land Survey
 Est. Accuracy: < 3 m, 3-5 m, 5-15 m, > 15 m

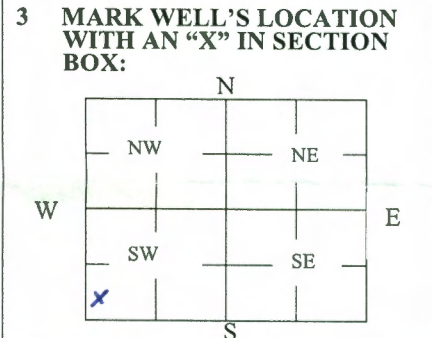

4 DEPTH OF WELL 55.55 ft.
WELL'S STATIC WATER LEVEL 28.65 ft
WELL WAS USED AS:

| | | |
|-------------------------------------|---|--|
| <input type="checkbox"/> Domestic | <input type="checkbox"/> Public Water Supply | <input checked="" type="checkbox"/> Dewatering |
| <input type="checkbox"/> Irrigation | <input type="checkbox"/> Oil Field Water Supply | <input checked="" type="checkbox"/> Monitoring <i>OBW-1D</i> |
| <input type="checkbox"/> Feedlot | <input type="checkbox"/> Domestic (Lawn & Garden) | <input type="checkbox"/> Injection Well |
| <input type="checkbox"/> Industrial | <input type="checkbox"/> Air Conditioning | <input type="checkbox"/> Other _____ |

Was a chemical/bacteriological sample submitted to Department? Yes No

5 TYPE OF BLANK CASING USED:

| | | | | |
|---|-----------------------------------|--|--|--|
| <input checked="" type="checkbox"/> Steel | <input type="checkbox"/> RMP (SR) | <input type="checkbox"/> Wrought | <input type="checkbox"/> Fiberglass | <input type="checkbox"/> Other (Specify below) _____ |
| <input checked="" type="checkbox"/> PVC | <input type="checkbox"/> ABS | <input type="checkbox"/> Asbestos-Cement | <input type="checkbox"/> Concrete Tile | |

Blank casing diameter 2 in. Was casing pulled? Yes No If yes, how much 3 ft
 Casing height above or below land surface -4 in.

6 GROUT PLUG MATERIAL: Neat cement Cement grout Bentonite Other _____

Grout Plug Intervals: From 55.55 ft. to 3 ft., From _____ ft. to _____ ft., From _____ ft. to _____ ft.

What is the nearest source of possible contamination:

| | | | |
|---|---|--|--|
| <input type="checkbox"/> Septic tank | <input type="checkbox"/> Seepage pit | <input checked="" type="checkbox"/> Fuel storage | <input type="checkbox"/> Other (specify below) _____ |
| <input type="checkbox"/> Sewer lines | <input type="checkbox"/> Pit privy | <input type="checkbox"/> Fertilizer storage | |
| <input type="checkbox"/> Watertight sewer lines | <input type="checkbox"/> Sewage lagoon | <input type="checkbox"/> Insecticide storage | |
| <input type="checkbox"/> Lateral lines | <input type="checkbox"/> Feedyard | <input type="checkbox"/> Abandoned water well | Direction from well? <u>NNW</u> |
| <input type="checkbox"/> Cess pool | <input type="checkbox"/> Livestock pens | <input type="checkbox"/> Oil well/Gas well | How many feet? <u>245</u> |

| FROM | TO | PLUGGING MATERIALS | FROM | TO | PLUGGING MATERIALS |
|-------|-----|--------------------------------------|------|----|--------------------|
| 55.55 | 3.0 | Enviroplug (Medium), bentonite chips | | | |
| | | | | | |
| | | | | | |
| | | | | | |
| | | | | | |

7 CONTRACTOR'S OR LANDOWNER'S CERTIFICATION: This water well was plugged under my jurisdiction and was completed on (mo/day/year) 03/12-2020 and this record is true to the best of my knowledge and belief. Kansas Water Well Contractor's License No. KDHE. This Water Well Record was completed on (mo/day/year) 03/12/2020 under the business name of KDHE - NWDO by (signature) Bill Heimann, KDHE NWDO, Hays *BH*

Send one white copy to Kansas Department of Health & Environment, Geology Section, 1000 SW Jackson Street, Ste. 420, Topeka, KS 66612-1367. Send one copy to WATER WELL OWNER and retain one for your records.
 Visit us at <http://www.kdheks.gov/waterwell/index.html> Telephone 785-296-5524.

Custom Metals

D&L Body Shop

BTEX: ND MW3

Drainage Ditch

Note the following Total BTEX Concentrations:
 VOBW2 - 93.9
 AS2 - 490
 AS3 - 6,938

Concrete

Shed

Former Dispenser Islands

1,000

AS3

SVE2

AS2

SVE5/AS7

AS1

VOBW2

SVE1

SVE4/AS6

VOBW1 (Destroyed)

AS5

SVE3

AS4

MW10

BTEX: ND
 As
 OBW1 BTEX: 345.5
 OBW1S

Former Product Line

RoofMasters
 Former Karst Water Well Service

Shop

Former UST

Former ASTs

BTEX: ND
 MW9

RW1D

Eighth Street (US Highway 40)

Existing USTs

Conoco Station

Apartments

100

Former Private

MW8
 BTEX: ND

ND

Not Sampled
 Rymph

Rymph Well
 Sample Port

El-Charro Apartments

Canterury Street

Herman



4/2/95 AG-026-40098 - Mel Karst
UG-026-10968
Both T & M site


MONITORING WELL INSTALLATION DIAGRAM

Well ID: OBW-1D
Client: Mel Karst

Project Name: Karst Water Well, Hays, Kansas
Project Number: 17101920

GROUND SURFACE
ELEVATION 1,994.95 feet

TOP OF CASING ✓
ELEVATION 1,994.56 feet

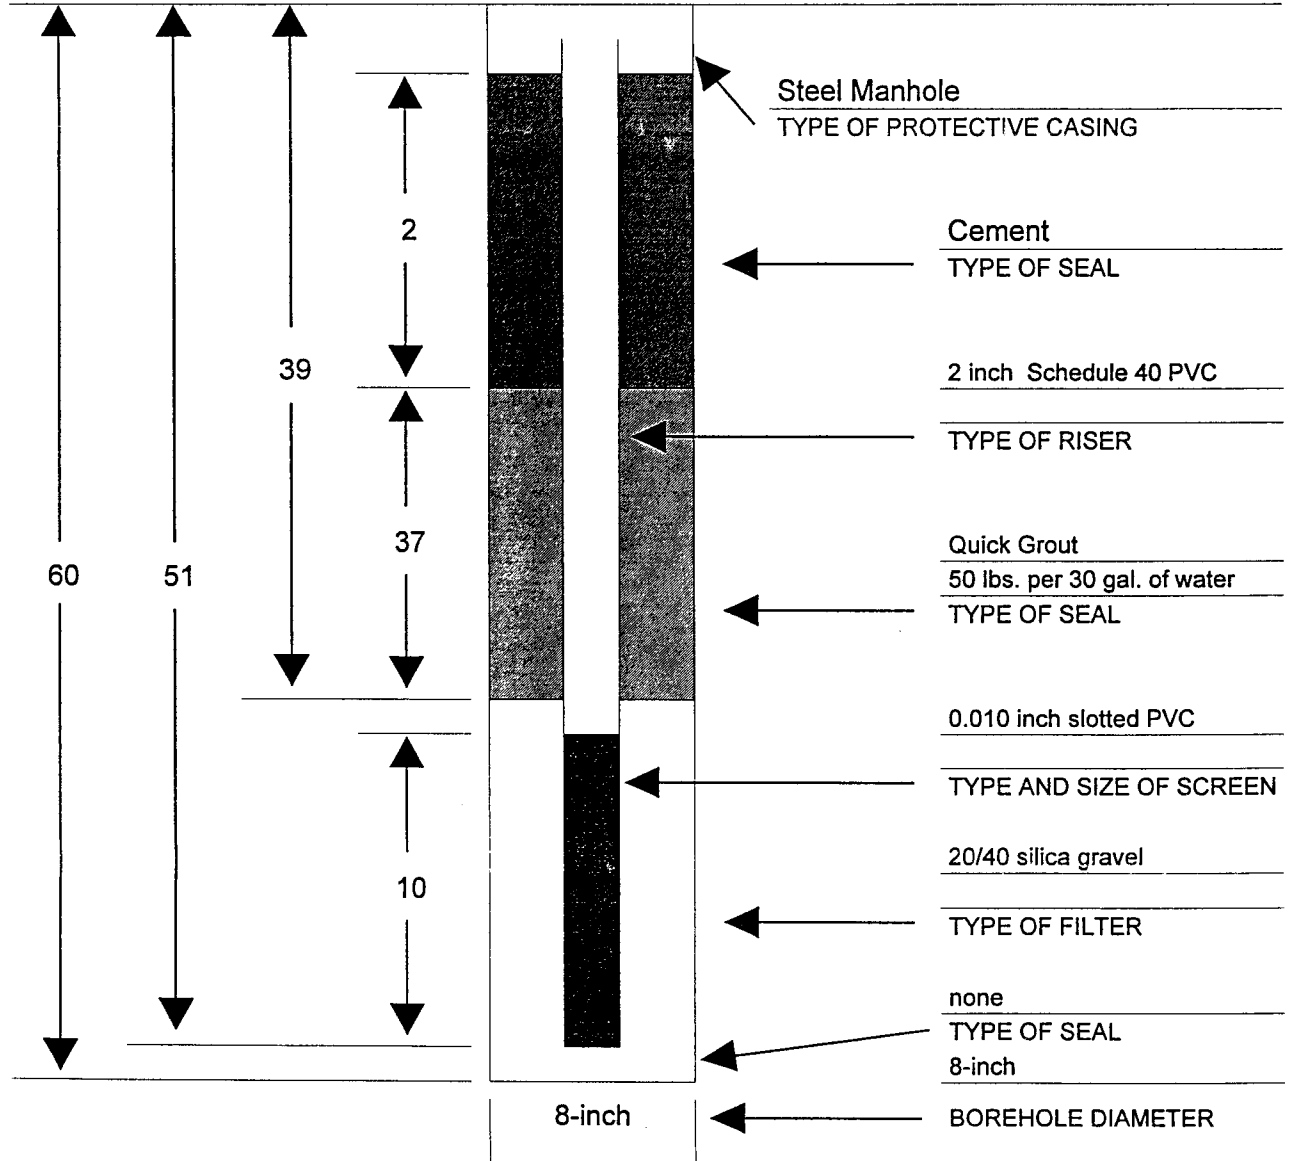

All measurements in feet unless otherwise noted.

10' Screen

