

WATER WELL PLUGGING RECORD

Form WWC-5P

KSA 82a-1212

ID NO.

MW-15

1 LOCATION OF WATER WELL:	Fraction County: <u>ELLIS</u>	Section Number <u>03</u>	Township Number T <u>14</u> S	Range Number R <u>18</u> E <input checked="" type="checkbox"/> W
Street/Rural Address of Well Location; if unknown, distance & direction from nearest town or intersection: If at owner's address, check here <input type="checkbox"/>		Global Positioning Systems (GPS) information:		
<u>6TH ST. E & SO VINE ST., HAYS IN E-W ALLEY, E. of Vine 65'</u>		Latitude: <u>38.86309</u> (in decimal degrees) Longitude: <u>-099.31759</u> (in decimal degrees) Elevation: <u>1983.03</u>		
		Horizontal Datum: <input checked="" type="checkbox"/> WGS84, <input type="checkbox"/> NAD83, <input type="checkbox"/> NAD27 Collection Method:		

2 WATER WELL OWNER:	<u>KDHE-BGR</u>	GPS unit (Make/Model): <u>Garmin GPS 72</u>
RR#, St. Address, Box #:	<u>Topeka, KS</u>	Digital Map/Photo, <input type="checkbox"/> Topographic Map, <input type="checkbox"/> Land Survey
City, State ZIP Code:		Est. Accuracy: <input checked="" type="checkbox"/> < 3 m, <input type="checkbox"/> 3-5 m, <input type="checkbox"/> 5-15 m, <input type="checkbox"/> > 15 m

3 MARK WELL'S LOCATION WITH AN "X" IN SECTION BOX:	N W E S	4 DEPTH OF WELL <u>35</u> ft. WELL'S STATIC WATER LEVEL <u>19.5</u> ft. WELL WAS USED AS:
		<input type="checkbox"/> Domestic <input type="checkbox"/> Irrigation <input type="checkbox"/> Feedlot <input type="checkbox"/> Industrial <input type="checkbox"/> Public Water Supply <input type="checkbox"/> Oil Field Water Supply <input type="checkbox"/> Domestic (Lawn & Garden) <input type="checkbox"/> Air Conditioning <input checked="" type="checkbox"/> Dewatering <input checked="" type="checkbox"/> Monitoring <input type="checkbox"/> Injection Well <input type="checkbox"/> Other _____
		Was a chemical/bacteriological sample submitted to Department? Yes <input type="checkbox"/> No <input checked="" type="checkbox"/>

5 TYPE OF BLANK CASING USED:	<input type="checkbox"/> Steel <input checked="" type="checkbox"/> PVC	<input type="checkbox"/> RMP (SR) <input type="checkbox"/> ABS	<input type="checkbox"/> Wrought Asbestos-Cement	<input type="checkbox"/> Fiberglass Concrete Tile	<input type="checkbox"/> Other (Specify below)
Blank casing diameter <u>2 1/2</u> in. Was casing pulled? Yes <input type="checkbox"/> No <input checked="" type="checkbox"/> If yes, how much <u>3' removed after cutting</u> Casing height above or below land surface <u>39</u> in. <u>After cutting</u>					

6 GROUT PLUG MATERIAL:	<input type="checkbox"/> Neat cement	<input type="checkbox"/> Cement grout	<input checked="" type="checkbox"/> Bentonite <u>CHIPS</u>	<input type="checkbox"/> Other _____
Grout Plug Intervals:	From <u>35</u> ft. to <u>3</u> ft.,	From <u>3</u> ft. to <u>0</u> ft.,	From _____ ft. to _____ ft.	
What is the nearest source of possible contamination:	<input type="checkbox"/> Septic tank <input checked="" type="checkbox"/> Sewer lines <input type="checkbox"/> Watertight sewer lines <input type="checkbox"/> Lateral lines <input type="checkbox"/> Cess pool <input type="checkbox"/> Seepage pit <input type="checkbox"/> Pit privy <input type="checkbox"/> Sewage lagoon <input type="checkbox"/> Feedyard <input type="checkbox"/> Livestock pens <input type="checkbox"/> Fuel storage <input type="checkbox"/> Fertilizer storage <input type="checkbox"/> Insecticide storage <input type="checkbox"/> Abandoned water well <input type="checkbox"/> Oil well/Gas well <input type="checkbox"/> Other (specify below) Direction from well? _____ How many feet? _____			

FROM	TO	PLUGGING MATERIALS	FROM	TO	PLUGGING MATERIALS
<u>35</u>	<u>3.3</u>	<u>BENTONITE CHIPS</u>			
<u>3.3</u>	<u>0</u>	<u>SOIL</u>			<u>RECEIVED</u>
					<u>NOV 25 2024</u>
					<u>BUREAU OF WATER</u>

7 CONTRACTOR'S OR LANDOWNER'S CERTIFICATION:	This water well was plugged under my jurisdiction and was completed on (mo/day/year) <u>11-7-2024</u> and this record is true to the best of my knowledge and belief. Kansas Water Well Contractor's License No. <u>KDHE</u> . This Water Well Record was completed on (mo/day/year) <u>11-18-2024</u> under the business name of <u>KDHE</u> by (signature) <u>Tillie Beinmann, KDHE-MWD</u>	
----------------------------------------------	---	--

Send one white copy to Kansas Department of Health & Environment, Geology Section, 1000 SW Jackson Street, Ste. 420, Topeka, KS 66612-1367. Send one copy to WATER WELL OWNER and retain one for your records.
Visit us at <http://www.kdheks.gov/waterwell/index.html> Telephone 785-296-5524.



LOG OF BORING

Sec.3-T.14-Rge.18W

Industrial Compliance Ellis County

BORING NO. MW-15

SHEET 1 OF 2

CLIENT				PROJECT				PROJECT NO.			
Kansas Department of Health & Environment				Hays, Kansas Phase II				5-1671			
PROJECT LOCATION				ELEVATION (DATUM)		TOTAL DEPTH		DATE START			
Hays, Kansas				1983.05		35.0'		10/06/92			
SURFACE CONDITIONS								DATE FINISH			
Gravel covered alley								10/06/92			
SAMPLE TYPE	SAMPLE NUMBER	SAMPLING	DRILLING CONTRACTOR	DRILL RIG	DRILLER	GEOLOGIST					
		SET 6' 2ND 6' 3RD 6' N VALUE SAMPLE RECOV.	J&R Drilling	D-50	J. Stoy	R. Lamb					
CORE SIZE	RUN NUMBER	CORING	REMARKS	SAMPLE TYPE	CLASSIFICATION OF MATERIAL	REMARKS					
CB	1			1	Silty CLAY; dark-brown; very stiff; low plasticity; moist; w/trace gravel & brick fragments (fill)	Boring advanced w/ 7 3/4" O.D., 3 3/4" I.D. hollow stem					
				2							
				3							
				4							
				5							
				6							
				7							
				8							
				9							
				10							
CB	2			11							
				12							
				13							
				14							
				15							
CB	3			16							
				17							
				18							
				19							
				20							
CB	4			21							
				22							
				23							
				24							
				25							
CB	5			26							
				27							
				28							
LOG OF BURTING

Sec.3-T.14-Rge.18W

Ellis County

BORING NO. MW-15

MW-15

Industrial Compliance

SHEET 2 OF 2


MW-15 Client KDHE
Job # 5-1671 Project Hays, Kansas

Industrial Compliance

MONITORING WELL INSTALLATION DIAGRAM

TOP OF CASING
ELEVATION 1982.64

GROUND SURFACE
ELEVATION 1983.05

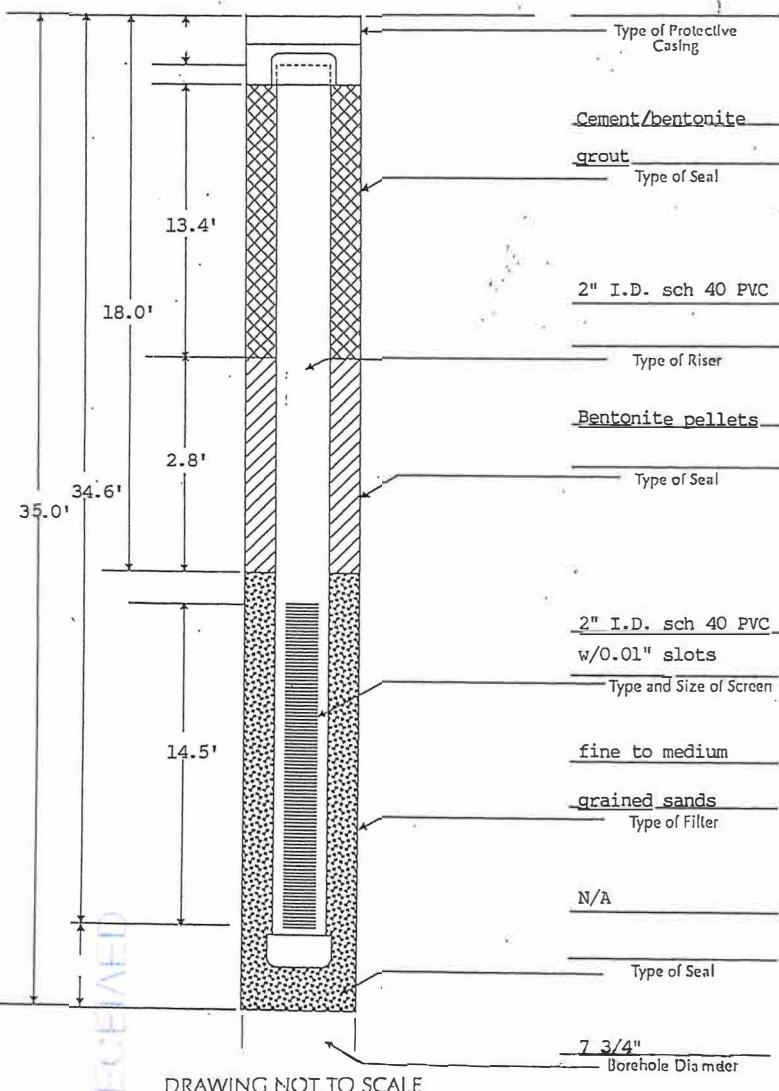

DRAWING NOT TO SCALE

Dedicated to solving your environmental problems.

ICM 201901


MW-16 Client KDHE
Job # 5-1671 Project Hays, Kansas

~~Industrial Compliance~~

MONITORING WELL INSTALLATION DIAGRAM

TOP OF CASING
ELEVATION 1982.76

GROUND SURFACE
ELEVATION 1983.16

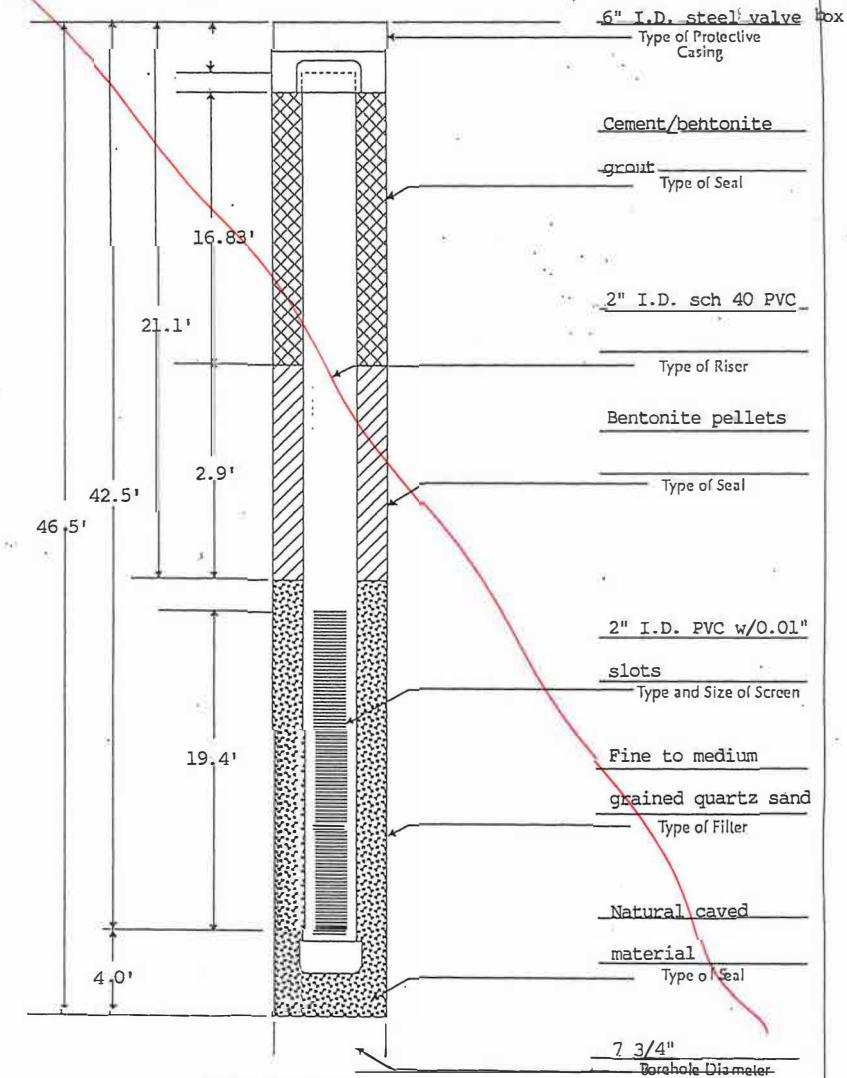

DRAWING NOT TO SCALE

Dedicated to solving your environmental problems.

ICM 201901

Sec.3-T.14-Rge.18W

Ellis County