

WATER WELL RECORD Form WWC-5 KSA 82a-1212


1] LOCATION OF WATER WELL: Fraction NW 1/4 SE 1/4 NE 1/4 Section Number 4 Township Number T 14 S Range Number R 18 EW

Distance and direction from nearest town or city street address of well if located within city?

20 feet East of 730 East Eight St.

2] WATER WELL OWNER: Kansasland Tire
 RR#, St. Address, Box # : 730 E. Eight St. Board of Agriculture, Division of Water Resource.
 City, State, ZIP Code : Hays, Kansas 67601 Application Number:

3] LOCATE WELL'S LOCATION WITH AN "X" IN SECTION BOX:

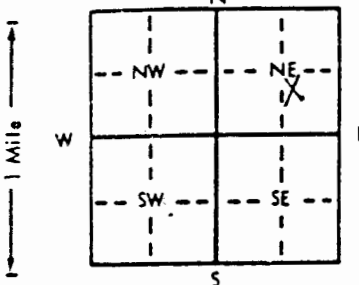

4] DEPTH OF COMPLETED WELL: 24 ft. ELEVATION:
 Depth(s) Groundwater Encountered 1. 20 ft. 2. ft. 3. ft.
 WELL'S STATIC WATER LEVEL . . . 17.88 ft. below land surface measured on mo/day/yr
 Pump test data: Well water was . . . ft after . . . hours pumping . . . gpm
 Est. Yield . . . gpm: Well water was . . . ft after . . . hours pumping . . . gpm
 Bore Hole Diameter . 7.5/8 . in. to . 25 . ft., and . . . in. to . . . ft.
 WELL WATER TO BE USED AS: 5 Public water supply 8 Air conditioning 11 Injection well
 1 Domestic 3 Feedlot 6 Oil field water supply 9 Dewatering 12 Other (Specify below)
 2 Irrigation 4 Industrial 7 Lawn and garden only 10 Monitoring well
 Was a chemical/bacteriological sample submitted to Department? Yes . . . No . . . X . . . : If yes, mo/day/yr sample was sub-
 mitted Water Well Disinfected? Yes No X

5] TYPE OF BLANK CASING USED: 5 Wrought iron 8 Concrete tile CASING JOINTS: Glued . . . Clamped . . .
 1 Steel 3 RMP (SR) 6 Asbestos-Cement 9 Other (specify below) Welded . . .
 2 PVC 4 ABS 7 Fiberglass . . . Threaded . . . X . . .
 Blank casing diameter . . . 2 . . in. to . . . 14 . . ft., Dia . . . in. to . . . ft., Dia . . . in. to . . . ft.
 Casing height above land surface . . . 0 . . in., weight . . . lbs./ft. Wall thickness or gauge No. . . sch. 40
 TYPE OF SCREEN OR PERFORATION MATERIAL: 7 PVC 10 Asbestos-cement
 1 Steel 3 Stainless steel 5 Fiberglass 8 RMP (SR) 11 Other (specify) . . .
 2 Brass 4 Galvanized steel 6 Concrete tile 9 ABS 12 None used (open hole)

SCREEN OR PERFORATION OPENINGS ARE: 5 Gauzed wrapped 8 Saw cut 11 None (open hole)
 1 Continuous slot 3 Mill slot 6 Wire wrapped 9 Drilled holes
 2 Louvered shutter 4 Key punched 7 Torch cut 10 Other (specify) . . .
 SCREEN-PERFORATED INTERVALS: From . . . 14 . . ft. to . . . 24 . . ft., From . . . ft. to . . . ft.
 From . . . ft. to . . . ft., From . . . ft. to . . . ft.
 GRAVEL PACK INTERVALS: From . . . 12 . . ft. to . . . 25 . . ft., From . . . ft. to . . . ft.
 From . . . ft. to . . . ft., From . . . ft. to . . . ft.

6] GROUT MATERIAL: 1 Neat cement 2 Cement grout 3 Bentonite 4 Other . . .
 Grout Intervals: From . . . 0 . . ft. to . . . 10 . . ft., From . . . 10 . . ft. to . . . 12 . . ft., From . . . ft. to . . . ft.
 What is the nearest source of possible contamination:
 1 Septic tank 4 Lateral lines 7 Pit privy 10 Livestock pens 14 Abandoned water well
 2 Sewer lines 5 Cess pool 8 Sewage lagoon 11 Fuel storage 15 Oil well/Gas well
 3 Watertight sewer lines 6 Seepage pit 9 Feedyard 12 Fertilizer storage 16 Other (specify below)
 13 Insecticide storage
 How many feet? Excavation

Direction from well? NA

FROM	TO	LITHOLOGIC LOG	FROM	TO	PLUGGING INTERVALS
0	6"	Concrete			
6"	10	(fill sand) f-c grnd, v grvly			
10	13	Cly, lt brn, w/ sl oran tint, mod f-c snd, mod plstc, v slty			
13	20	Cly, lt brn, w/ sl oran tint, v slty damp, sl plstc			
20	25	Cly, as above, but sat @ 20', mod-v sndy, v f-f grnd			

MW1 - Flushmount
 Don Taylor

7] CONTRACTOR'S OR LANDOWNER'S CERTIFICATION: This water well was (1) constructed, (2) reconstructed, or (3) plugged under my jurisdiction and was completed on (mo/day/year) . . . 11-10-94 . . . and this record is true to the best of my knowledge and belief. Kansas Water Well Contractor's License No. . . 527 . . . This Water Well Record was completed on (mo/day/yr) . . . 11-15-94 . . . under the business name of GebCore Services, Inc. by (signature) Don Taylor