

**CORRECTION TO WATER WELL RECORD (WWC-5)**

The following correction(s) was made to the attached WWC-5 log, in order to file the item or to rectify lacking or incorrect information.

**Fraction ( 1/4 1/4 1/4) Section-Township-Range changed:**

listed as Nothing

changed to NW, SE, NE, sec. 4, T14S, R18W

**Other changes made:**

Initial statements: \_\_\_\_\_

\_\_\_\_\_  
\_\_\_\_\_

Changed to: \_\_\_\_\_

\_\_\_\_\_

Plat Map on WWC-5 form &  
verificaton method: Hays South 1:24,000 Topographic Map initials: DRd date: 11/18/98


submitted by: Kansas Geological Survey, Data Resources Library, 1930 Constant Ave., Lawrence, KS 66047-3726  
to: Kansas Dept of Health & Environment Bureau of Water Industrial Programs, Bldg 283, Forbes Field, KS 66620

1 LOCATION OF WATER WELL: Fraction  $\frac{1}{4}$   $\frac{1}{4}$   $\frac{1}{4}$  Section Number Township Number Range Number  
 County: Ellis T S R EW

Distance and direction from nearest town or city street address of well if located within city?  
 80 feet East of E. Eight St.

2 WATER WELL OWNER: Kansasland Tire  
 RR#, St. Address, Box #: 730 W. Eight St. Board of Agriculture, Division of Water Resource  
 City, State, ZIP Code: Hays, Kansas 67601 Application Number:

3 LOCATE WELL'S LOCATION WITH AN "X" IN SECTION BOX:

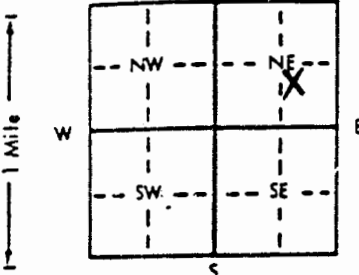

4 DEPTH OF COMPLETED WELL: 23 ft. ELEVATION:  
 Depth(s) Groundwater Encountered 1. 17 ft. 2. ft. 3. ft.  
 WELL'S STATIC WATER LEVEL: 17.91 ft. below land surface measured on mo/day/yr  
 Pump test data: Well water was ft. after hours pumping gpm  
 Est. Yield gpm: Well water was ft. after hours pumping gpm  
 Bore Hole Diameter: 8 in. to 23 in. and in. to ft.  
 WELL WATER TO BE USED AS:  
 5 Public water supply 8 Air conditioning 11 Injection well  
 1 Domestic 3 Feedlot 8 Oil field water supply 9 Dewatering 12 Other (Specify below)  
 2 Irrigation 4 Industrial 7 Lawn and garden only 10 Monitoring well  
 Was a chemical/bacteriological sample submitted to Department? Yes No X; If yes, mo/day/yr sample was submitted Water Well Disinfected? Yes No X

5 TYPE OF CASING USED:  
 1 Steel 3 RMP (SR) 5 Wrought iron 8 Concrete tile CASING JOINTS: Glued Clamped  
 2 PVC 4 ABS 6 Asbestos-Cement 9 Other (specify below) Welded  
 7 Fiberglass Threaded X  
 Blank casing diameter 2 in. to 13 ft. Dia. in. to ft. Dia. in. to ft.  
 Casing height above land surface 0 in. weight lbs./ft. Wall thickness or gauge No. sch. 40

TYPE OF SCREEN OR PERFORATION MATERIAL:  
 1 Steel 3 Stainless steel 5 Fiberglass 7 PVC 10 Asbestos-cement  
 2 Brass 4 Galvanized steel 6 Concrete tile 8 RMP (SR) 11 Other (specify)  
 12 None used (open hole)

SCREEN-OR PERFORATION OPENINGS ARE:  
 1 Continuous slot 3 Mill slot 5 Gauzed wrapped 8 Saw cut 11 None (open hole)  
 2 Louvered shutter 4 Key punched 6 Wire wrapped 9 Drilled holes  
 7 Torch cut 10 Other (specify)  
 SCREEN-PERFORATED INTERVALS: From 13 ft. to 23 ft. From ft. to ft.  
 GRAVEL PACK INTERVALS: From 11 ft. to 23 ft. From ft. to ft.

6 GROUT MATERIAL: 1 Neat cement 2 Cement grout 3 Bentonite 4 Other  
 Grout intervals: From 0 ft. to 9 ft. From 9 ft. to 11 ft. From ft. to ft.  
 What is the nearest source of possible contamination:  
 1 Septic tank 4 Lateral lines 7 Pit privy 10 Livestock pens 14 Abandoned water well  
 2 Sewer lines 5 Cess pool 8 Sewage lagoon 11 Fuel storage 15 Oil well/Gas well  
 3 Watertight sewer lines 6 Seepage pit 9 Feedyard 12 Fertilizer storage 16 Other (specify below)  
 13 Insecticide storage  
 Direction from well? Southwest How many feet? 70

FROM	TO	LITHOLOGIC LOG	FROM	TO	PLUGGING INTERVALS
0	4"	Concrete	20	24	Snd, f-c grnd prly srted w/ sl grvl
4"	1'	Cly, lt brn, v slty, lots of snd-grvl szd calic clsts, dry			v slty, sl cly, lt gry clrd
1	3.5	Cly, med brn, v slty, damp, mod plstc, tr of snd-grvl szd calic			
3.5	5	Cly, drk brn, mod-v slty, mod plstc damp			
5	10	Cly, drk brn, w/ sl gry tint, v slty, sl plstc, damp			
10	16	Cly, lt gry, v slty, damp, tr of calic clsts, sl plstc			
16	18	Cly, lt-gry-brn, v slty, sl plstc, damp			MW6 - Flushmount
18	20	Snd, v f-f grnd, lt brn mod-v clyey frly well srted			Don Taylor

7 CONTRACTOR'S OR LANDOWNER'S CERTIFICATION: This water well was (1) constructed, (2) reconstructed, or (3) plugged under my jurisdiction and was completed on (mo/day/year) 10-11-94 and this record is true to the best of my knowledge and belief. Kansas Water Well Contractor's License No. 527 This Water Well Record was completed on (mo/day/yr) 11-15-94 under the business name of GebCore Services, Inc. by (signature) Dale Bell