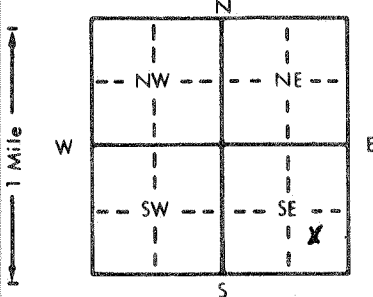


1 LOCATION OF WATER WELL: County: Ellis Fraction: NW 1/4 SE 1/4 SE 1/4 Section Number: 3 Township Number: T 14 S Range Number: R 18 E(W)

Distance and direction from nearest town or city street address of well if located within city?  
2000 Front Street, Hays KS MW-4

2 WATER WELL OWNER: Pepsi Cola  
 RR#, St. Address, Box #: 101 W, 48th St, South  
 City, State, ZIP Code: Wichita, KS 67217  
 Board of Agriculture, Division of Water Resources  
 Application Number:

3 LOCATE WELL'S LOCATION WITH AN "X" IN SECTION BOX:  
  
 4 DEPTH OF COMPLETED WELL: 44.0 ft. ELEVATION:  
 Depth(s) Groundwater Encountered 1. 3.4 ft. 2. ft. 3. ft.  
 WELL'S STATIC WATER LEVEL: 36.02 ft. below land surface measured on mo/day/yr 11/3/94  
 Pump test data: Well water was ft. after hours pumping gpm  
 Est. Yield gpm: Well water was ft. after hours pumping gpm  
 Bore Hole Diameter in. to ft., and in. to ft.  
 WELL WATER TO BE USED AS:  
 1 Domestic 3 Feedlot 6 Oil field water supply 9 Dewatering 11 Injection well  
 2 Irrigation 4 Industrial 7 Lawn and garden only 10 Monitoring well 12 Other (Specify below)  
 Was a chemical/bacteriological sample submitted to Department? Yes No; If yes, mo/day/yr sample was submitted  
 Water Well Disinfected? Yes No

5 TYPE OF BLANK CASING USED:  
 1 Steel 3 RMP (SR) 5 Wrought iron 8 Concrete tile CASING JOINTS: Glued Clamped  
2 PVC 4 ABS 6 Asbestos-Cement 9 Other (specify below) Welded  
 7 Fiberglass Threaded  
 Blank casing diameter 2 in. to 29.0 ft., Dia. in. to ft., Dia. in. to ft.  
 Casing height above land surface Flush Mount in., weight lbs./ft. Wall thickness or gauge No. sch. 40  
 TYPE OF SCREEN OR PERFORATION MATERIAL:  
 1 Steel 3 Stainless steel 5 Fiberglass 8 RMP (SR) 10 Asbestos-cement 11 Other (specify)  
 2 Brass 4 Galvanized steel 6 Concrete tile 9 ABS 12 None used (open hole)  
 SCREEN OR PERFORATION OPENINGS ARE:  
 1 Continuous slot 3 Mill slot 6 Wire wrapped 8 Saw cut 11 None (open hole)  
 2 Louvered shutter 4 Key punched 7 Torch cut 9 Drilled holes 10 Other (specify)  
 SCREEN-PERFORATED INTERVALS: From 29.0 ft. to 44.0 ft., From ft. to ft.  
 GRAVEL PACK INTERVALS: From 28.0 ft. to 44.0 ft., From ft. to ft.

6 GROUT MATERIAL: 1 Neat cement 2 Cement grout 3 Bentonite 4 Other  
 Grout Intervals: From 0 ft. to 26.0 ft., From 26.0 ft. to 28 ft., From ft. to ft.  
 What is the nearest source of possible contamination:  
 1 Septic tank 4 Lateral lines 7 Pit privy 10 Livestock pens 14 Abandoned water well  
 2 Sewer lines 5 Cess pool 8 Sewage lagoon 11 Fuel storage (Former) 15 Oil well/Gas well  
 3 Watertight sewer lines 6 Seepage pit 9 Feedyard 12 Fertilizer storage 16 Other (specify below)  
 13 Insecticide storage  
 Direction from well? West How many feet? 80'

FROM	TO	LITHOLOGIC LOG	FROM	TO	PLUGGING INTERVALS
0'	2.5'	Topsoil, clay, dark brown			
2.5'	15.0'	clay w/silt, brown			
15.0'	20.0'	clay w/silt, brown, slight petr. odor			
20.0'	35.0'	clay w/silt, brown, strong petr. odor			
35.0'	44.0'	sand, medium grained, w/clay, silt, slight petroleum odor			

7 CONTRACTOR'S OR LANDOWNER'S CERTIFICATION: This water well was (1) constructed, (2) reconstructed, or (3) plugged under my jurisdiction and was completed on (mo/day/year) 10/30/94 and this record is true to the best of my knowledge and belief. Kansas Water Well Contractor's License No. 438 This Water Well Record was completed on (mo/day/yr) 11/3/94 under the business name of Kansas City Testing Lab by (signature) Charles Harper

INSTRUCTIONS: Use typewriter or ball point pen. PLEASE PRESS FIRMLY and PRINT clearly. Please fill in blanks, underline or circle the correct answers. Send top three copies to Kansas Department of Health and Environment, Bureau of Water, Topeka, Kansas 66620-0001. Telephone: 913-296-5545. Send one to WATER WELL OWNER and retain one for your records.