

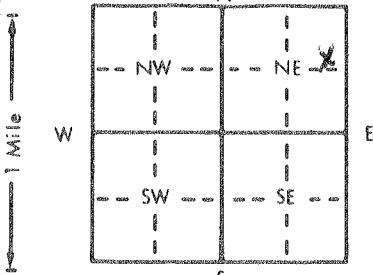
MW-3 2211028

WATER WELL RECORD Form WWC-5 KSA 82a-1212

1 LOCATION OF WATER WELL: Fraction NE 1/4 NE 1/4 NE 1/4 Section Number 3 Township Number T 14 S Range Number R 19W E/W  
 County: Ellis

Distance and direction from nearest town or city street address of well if located within city?  
196' W & 31' S of S.W. cor. Eastgate Center

2 WATER WELL OWNER: KDHE  
 RR#, St. Address, Box #: Forbes Field, Bldg. 740 Board of Agriculture, Division of Water Resources  
 City, State, ZIP Code: Topeka, Ks 66670-001 Application Number:

3 LOCATE WELL'S LOCATION WITH AN "X" IN SECTION BOX:  


4 DEPTH OF COMPLETED WELL: 32 ft. ELEVATION:  
 Depth(s) Groundwater Encountered 1. 24.9 ft. 2. ft. 3. ft.  
 WELL'S STATIC WATER LEVEL 23.73 ft. below land surface measured on mo/day/yr 8/16/94 10/11/94  
 Pump test data: Well water was ft. after hours pumping gpm  
 Est. Yield gpm Well water was ft. after hours pumping gpm  
 Bore Hole Diameter 8 in. to ft., and in. to ft.  
 WELL WATER TO BE USED AS:  
 1 Domestic 3 Feedlot 6 Oil field water supply 9 Dewatering 11 Injection well  
 2 Irrigation 4 Industrial 7 Lawn and garden only 10 Monitoring well 12 Other (Specify below)  
 Was a chemical/bacteriological sample submitted to Department? Yes No X If yes, mo/day/yr sample was submitted Water Well Disinfected? Yes No X

5 TYPE OF BLANK CASING USED:  
 1 Steel 3 RMP (SR) 5 Wrought iron 8 Concrete tile CASING JOINTS: Glued Clamped  
2 PVC 4 ABS 6 Asbestos-Cement 9 Other (specify below) Welded  
 7 Fiberglass Threaded Flush  
 Blank casing diameter 2 in. to ft., Dia. in. to ft., Dia. in. to ft.  
 Casing height above land surface: Flush in., weight 703 lbs./ft. Wall thickness or gauge No. 154  
 TYPE OF SCREEN OR PERFORATION MATERIAL:  
 1 Steel 3 Stainless steel 5 Fiberglass 7 PVC 10 Asbestos-cement  
 2 Brass 4 Galvanized steel 6 Concrete tile 8 RMP (SR) 11 Other (specify)  
 12 None used (open hole)  
 SCREEN OR PERFORATION OPENINGS ARE:  
 1 Continuous slot 3 Mill slot 5 Gauzed wrapped 8 Saw cut 11 None (open hole)  
 2 Louvered shutter 4 Key punched 6 Wire wrapped 9 Drilled holes  
 7 Torch cut 10 Other (specify)  
 SCREEN-PERFORATED INTERVALS: From 17 ft. to 32 ft., From ft. to ft.  
 GRAVEL PACK INTERVALS: From 14 ft. to 32 ft., From ft. to ft.

6 GROUT MATERIAL: 1 Neat cement 2 Cement grout 3 Bentonite 4 Other  
 Grout Intervals: From 14 ft. to 3 ft., From ft. to ft., From ft. to ft.  
 What is the nearest source of possible contamination:  
 1 Septic tank 4 Lateral lines 7 Pit privy 11 Fuel storage 14 Abandoned water well  
 2 Sewer lines 5 Cess pool 8 Sewage lagoon 12 Fertilizer storage 15 Oil well/Gas well  
 3 Watertight sewer lines 6 Seepage pit 9 Feedyard 13 Insecticide storage 16 Other (specify below)  
 Direction from well? S, W How many feet? 500

| FROM | TO   | LITHOLOGIC LOG     | FROM | TO | PLUGGING INTERVALS |
|------|------|--------------------|------|----|--------------------|
| 0.0  | 2.0  | Clay, sandy        |      |    |                    |
| 2.0  | 26.0 | Clay, silty        |      |    |                    |
| 26.0 | 32.0 | Clay, silty, sandy |      |    |                    |

7 CONTRACTOR'S OR LANDOWNER'S CERTIFICATION: This water well was (1) constructed, (2) reconstructed, or (3) plugged under my jurisdiction and was completed on (mo/day/year) 8/16 10/11/94 and this record is true to the best of my knowledge and belief. Kansas Water Well Contractor's License No. 531 This Water Well Record was completed on (mo/day/yr) 11/1/94 under the business name of GSI by (signature) Brygg Armstrong

INSTRUCTIONS: Use typewriter or ball point pen. PLEASE PRESS FIRMLY and PRINT clearly. Please fill in blanks, underline or circle the correct answers. Send top three copies to Kansas Department of Health and Environment, Bureau of Water, Topeka, Kansas 66620-0001. Telephone: 913-296-5545. Send one to WATER WELL OWNER and retain one for your records.