


USE TYPEWRITER OR BALL POINT PEN-PRESS FIRMLY, PRINT CLEARLY.

WATER WELL RECORD
KSA 82a-1201-1215

Kansas Department of Health and Environment-Division of Environment
(Water well Contractors)
Topeka, Kansas 66620

1. Location of well: County Ellis Section NE 1/4 NE 1/4 NW 1/4 Section number 8 Township number T 14 S R 19 E W Range number

2. Distance and direction from nearest town or city: 7 West of Hays Street address of well location if in city: 209 E. 20th
3. Owner of well: Louis Riedel R.R. or street: 209 E. 20th City, state, zip code: Hays, Kansas 67601

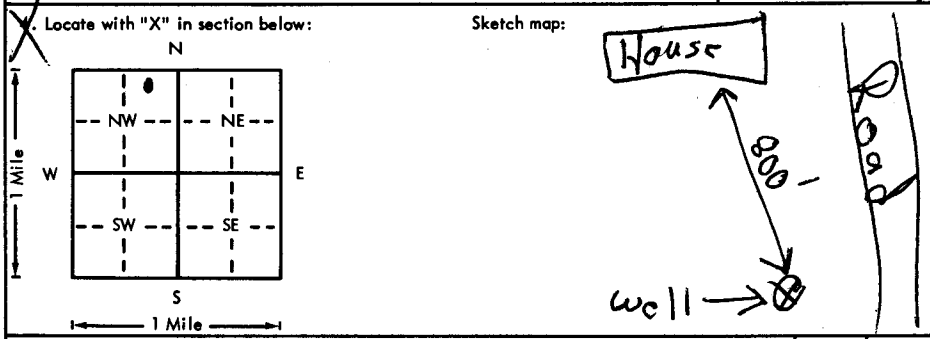

6. Bore hole dia. 9 in. Completion date 9/10/75
Well depth 90 ft.

7. Cable tool Rotary Driven Dug
 Hollow rod Jetted Bored Reverse rotary

8. Use: Domestic Public supply Industry
 Irrigation Air conditioning Stack
 Lown Oil field water Other

Casing: Material PVC Height: Above or below
Threaded Welded Surface 15 in.
RMP PVC Weight 2.8 lbs./ft.
Dia. 3 in. to 9 ft. depth Wall thickness: inches or
Dia. 3 in. to 9 ft. depth gage No. 258

5. Type and color of material	From	To
Topsoil	0	4
Rocky Subsoil	5	12
Hard White Rock	12	86
Blue Shale	86	90

10. Screen: Manufacturer's name Jet Stream

Type PVC Dia. 5"
 Slot gauze Length 15'
Set between 75 ft. and 90 ft.
Gravel pack? Yes Size range of material 1/4-1/2"

11. Static water level: 40 ft. below land surface Date 9/10/75 mo./day/yr.

12. Pumping level below land surfaces:
85 ft. after 2 hrs. pumping 8 g.p.m.
ft. after hrs. pumping g.p.m.
Estimated maximum yield 8 g.p.m.

13. Water sample submitted: mo./day/yr.
Yes No Date

14. Well head completion:
 Pitless adapter Inches above grade

Well grouted? Yes
With: Neat cement Bentonite Concrete
Depth: From 5 ft. to 13 ft.

Nearest source of possible contamination: None
ft. Direction Type
Well disinfected upon completion? Yes No

17. Pump: Not installed
Manufacturer's name Fairbanks Morris
Model number HP 3/4 Volts 220
Length of drop pipe 85 ft. capacity 8 g.p.m.
Type Submersible Turbine
 Jet Reciprocating
 Centrifugal Other

18. Elevation:
Topography:
 Hill
 Slope
 Upland
 Valley

19. Remarks:
None

Water well contractor's certification:
This well was drilled under my jurisdiction and this report is true to the best of my knowledge and belief.
Karst Water Well 1999A 1/4
Business name License No. 1/4
Address E. Hwy 40 Hays
Signed Date 9/10/75 1/4
Authorized representative

Forward the white, blue and pink copies to the Department of Health and Environment

Form WWC-5