


1 LOCATION OF WATER WELL: Fraction NE 1/4 SE 1/4 NE 1/4 Section Number 23 Township Number T 14 S Range Number R 19 E/W
 County: Ellis

Distance and direction from nearest town or city street address of well if located within city?

2 miles south of Hays on 183; 4 west; 1/4 south

2 WATER WELL OWNER: Edmund/Pete Befort
 RR#, St. Address, Box # : 1316 Munjor Rd Board of Agriculture, Division of Water Resources
 City, State, ZIP Code : Hays KS 67601 Application Number:

3 LOCATE WELL'S LOCATION WITH AN "X" IN SECTION BOX:

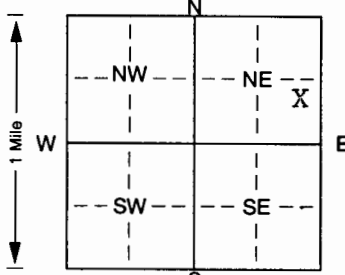

4 DEPTH OF COMPLETED WELL: 50 ft. ELEVATION: valley
 Depth(s) Groundwater Encountered 1. 30 ft. 2. 30 ft. 3. 30 ft.
 WELL'S STATIC WATER LEVEL: 20 ft. below land surface measured on mo/day/yr 10/18/00
 Pump test data: Well water was 20 ft. after 2 hours pumping 15 gpm
 Est. Yield 15 gpm: Well water was 20 ft. after 2 hours pumping 15 gpm
 Bore Hole Diameter: 10 in. to 50 ft., and 10 in. to 50 ft.
 WELL WATER TO BE USED AS: 1 Domestic 3 Feedlot 6 Oil field water supply 9 Dewatering 12 Other (Specify below)
 2 Irrigation 4 Industrial 7 Domestic (lawn & garden) 10 Monitoring well
 Was a chemical/bacteriological sample submitted to Department? Yes. No. X; If yes, mo/day/yr sample was submitted Water Well Disinfected? Yes X No

5 TYPE OF BLANK CASING USED: 2 PVC 5 Wrought iron 8 Concrete tile CASING JOINTS: Glued. X Clamped. Welded
 1 Steel 3 RMP (SR) 6 Asbestos-Cement 9 Other (specify below) Threaded.
 4 ABS 7 Fiberglass
 Blank casing diameter 5 in. to 20 ft., Dia. 5 in. to 20 ft., Dia. 5 in. to 20 ft.
 Casing height above land surface 24 in., weight 2.29 lbs./ft. Wall thickness or gauge No. .26

TYPE OF SCREEN OR PERFORATION MATERIAL: 7 PVC 10 Asbestos-cement
 1 Steel 3 Stainless steel 5 Fiberglass 8 RMP (SR) 11 Other (specify)
 2 Brass 4 Galvanized steel 6 Concrete tile 9 ABS 12 None used (open hole)

SCREEN OR PERFORATION OPENINGS ARE: 8 Saw cut 11 None (open hole)
 1 Continuous slot 3 Mill slot 6 Wire wrapped 9 Drilled holes
 2 Louvered shutter 4 Key punched 7 Torch cut 10 Other (specify) ft.

SCREEN-PERFORATED INTERVALS: From 50 ft. to 20 ft., From 50 ft. to 20 ft., From 50 ft. to 20 ft.
 GRAVEL PACK INTERVALS: From 20 ft. to 50 ft., From 20 ft. to 50 ft., From 20 ft. to 50 ft.

6 GROUT MATERIAL: 3 Bentonite 4 Other
 Grout Intervals: From 0 ft. to 20 ft., From 0 ft. to 20 ft., From 0 ft. to 20 ft.
 What is the nearest source of possible contamination: 10 Livestock pens 14 Abandoned water well
 1 Septic tank 4 Lateral lines 7 Pit privy 11 Fuel storage 15 Oil well/Gas well
 2 Sewer lines 5 Cess pool 8 Sewage lagoon 12 Fertilizer storage 16 Other (specify below)
 3 Watertight sewer lines 6 Seepage pit 9 Feedyard 13 Insecticide storage
 Direction from well? North How many feet? 100

FROM	TO	LITHOLOGIC LOG	FROM	TO	PLUGGING INTERVALS
0	4	Topsoil			
4	6	Gumbo			
6	12	Loose rock			
12	15	Gumbo			
15	25	Loose rock			
25	30	Gumbo			
30	32	Sand			
32	36	Weathered shale			
36	50	Shale			

7 CONTRACTOR'S OR LANDOWNER'S CERTIFICATION: This water well was (1) constructed, (2) reconstructed, or (3) plugged under my jurisdiction and was completed on (mo/day/year) 10/18/00 and this record is true to the best of my knowledge and belief. Kansas Water Well Contractor's Licence No. 199 This Water Well Record was completed on (mo/day/yr) 10/30/00 under the business name of Karst Water Well Drilling & Service, Inc. by (signature) Mel Karst