


1 LOCATION OF WATER WELL: Fraction NW 1/4 SE 1/4 SW 1/4 Section Number 19 Township Number T 14 S Range Number R 2 EW

Distance and direction from nearest town or city street address of well if located within city?
 1505 AUSTIN CIRCLE

2 WATER WELL OWNER: JOE MILLER
 RR#, St. Address, Box # : 1505 AUSTIN CIRCLE Board of Agriculture, Division of Water Resources
 City, State, ZIP Code : SALINA, KS. 67401 Application Number:

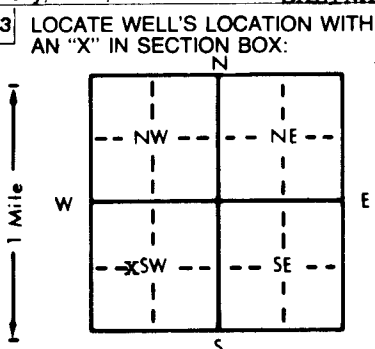

4 DEPTH OF COMPLETED WELL... 47 ft. ELEVATION: 1230
 Depth(s) Groundwater Encountered 1... 13.10 ft. 2... ft. 3... ft.
 WELL'S STATIC WATER LEVEL... 13.10 ft. below land surface measured on mo/day/yr 9-7-95
 Pump test data: Well water was 14.5 ft. after 1 hours pumping 30 gpm
 Est. Yield 75+ gpm; Well water was ft. after hours pumping gpm
 Bore Hole Diameter... 9 in. to 49 ft., and... in. to ft.
 WELL WATER TO BE USED AS:
 5 Public water supply 8 Air conditioning 11 Injection well
 1 Domestic 3 Feedlot 6 Oil field water supply 9 Dewatering 12 Other (Specify below)
 2 Irrigation 4 Industrial 7 Law and garden only 10 Monitoring well
 Was a chemical/bacteriological sample submitted to Department? Yes... No... X... If yes, mo/day/yr sample was submitted
 Water Well Disinfected? Yes X No

5 TYPE OF BLANK CASING USED:
 1 Steel 3 RMP (SR) 5 Wrought iron 8 Concrete tile CASING JOINTS: Glued X Clamped
 2 PVC 4 ABS 6 Asbestos-Cement 9 Other (specify below) Welded
 7 Fiberglass Threaded
 Blank casing diameter... 5 in. to 37 ft., Dia... in. to ft., Dia... in. to ft.
 Casing height above land surface... 18 in., weight... 160 lbs./ft. Wall thickness or gauge No. SDR 26
 TYPE OF SCREEN OR PERFORATION MATERIAL:
 1 Steel 3 Stainless steel 5 Fiberglass 8 RMP (SR) 10 Asbestos-cement 11 Other (specify)
 2 Brass 4 Galvanized steel 6 Concrete tile 9 ABS 12 None used (open hole)
 SCREEN OR PERFORATION OPENINGS ARE:
 1 Continuous slot 3 Mill slot .035 5 Gauzed wrapped 8 Saw cut 11 None (open hole)
 2 Louvered shutter 4 Key punched 37 7 Torch cut 47 9 Drilled holes 10 Other (specify)
 SCREEN-PERFORATED INTERVALS: From... ft. to... ft., From... ft. to... ft.
 GRAVEL PACK INTERVALS: From... 30 ft. to... 47 ft., From... ft. to... ft.

6 GROUT MATERIAL: 1 Neat cement 2 Cement grout 3 Bentonite 4 Other
 Grout Intervals: From... 5 ft. to... 30 ft., From... ft. to... ft.
 What is the nearest source of possible contamination:
 1 Septic tank 4 Lateral lines 7 Pit privy 10 Livestock pens 14 Abandoned water well
 2 Sewer lines 5 Cess pool 8 Sewage lagoon 11 Fuel storage 15 Oil well/Gas well
 3 Watertight sewer lines 6 Seepage pit 9 Feedyard 12 Fertilizer storage 16 Other (specify below)
 13 Insecticide storage
 Direction from well? NORTHWEST How many feet? 14

FROM	TO	LITHOLOGIC LOG	FROM	TO	PLUGGING INTERVALS
0	5	FILL DIRT			
5	17	CLAY TAN SILTY			
17	47	SAND FINE TO COARSE TAN			

7 CONTRACTOR'S OR LANDOWNER'S CERTIFICATION: This water well was (1) constructed, (2) reconstructed, or (3) plugged under my jurisdiction and was completed on (mo/day/year) 9-7-95 and this record is true to the best of my knowledge and belief. Kansas Water Well Contractor's License No. 388 This Water Well Record was completed on (mo/day/yr) 9-7-95 under the business name of PESTINGER PUMP SERVICE by (signature) [Signature]

OFFICE USE ONLY
T
R
EW
SEC.
1/4
1/4
1/4