


WATER WELL RECORD Form WWC-5 KSA 82a-1212

1 LOCATION OF WATER WELL: County: Saline Fraction NW 1/4 NW 1/4 NW 1/4 Section Number 18 Township Number T 14 S Range Number R 2 EW

Distance and direction from nearest town or city street address of well if located within city? 1100 East Iron - Salina, Kansas

2 WATER WELL OWNER: Green Lantern, Inc. RR#, St. Address, Box #: P.O. Box 856 City, State, ZIP Code: Salina, Kansas 67402-0856 Board of Agriculture, Division of Water Resources Application Number:

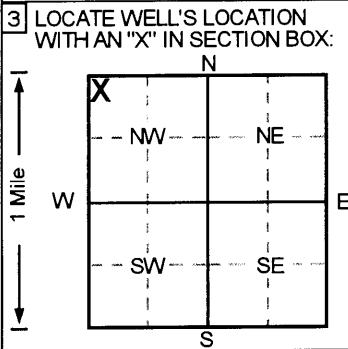

3 LOCATE WELL'S LOCATION WITH AN "X" IN SECTION BOX: 4 DEPTH OF COMPLETED WELL: 35 ft. ELEVATION: 1220.57. WELL'S STATIC WATER LEVEL: 24.38 ft. below land surface measured on 7/26/96. Pump test data: Well water was NA ft. after NA hours pumping. Est. Yield NA gpm. Bore Hole Diameter 8 in. to 35 ft. WELL WATER TO BE USED AS: 10 Monitoring well.

5 TYPE OF BLANK CASING USED: 2 PVC. Blank casing diameter 2 in. to 20 ft. Dia. Casing height above land surface -4.2 in., weight lbs./ft. Wall thickness or gauge No. Sch. 40. TYPE OF SCREEN OR PERFORATION MATERIAL: 7 PVC. SCREEN OR PERFORATION OPENINGS ARE: 3 Mill slot. SCREEN-PERFORATED INTERVALS: From 20 ft. to 35 ft. GRAVEL PACK INTERVALS: From 18.5 ft. to 35 ft.

6 GROUT MATERIAL: 2 Cement grout. Grout Intervals: From 0 ft. to 16.5 ft., From 16.5 ft. to 18.5 ft. What is the nearest source of possible contamination: 16 Other (specify below) UST Basin. Direction from well? S How many feet? 120

Table with columns: FROM, TO, LITHOLOGIC LOG, FROM, TO, PLUGGING INTERVALS. Rows include: 0-0.33 Asphalt, 0.33-8 Clay, Medium Brown, 8-15 Sand, Light Yellow Brown, 15-21 Sand, Light Gray Brown, 21-30 Sand, Light Gray Brown, 30-35 Sand, Light Gray.

7 CONTRACTOR'S OR LANDOWNER'S CERTIFICATION: This water well was (1) constructed, (2) reconstructed, or (3) plugged under my jurisdiction and was completed on (mo/day/year) 6/24/96 and this record is true to the best of my knowledge and belief. Kansas Water Well Contractor's License No. 527 This Water Well Record was completed on (mo/day/yr) 7/24/96 under the business name of GeoCore Services, Inc. by (signature) Dale A. Bell

INSTRUCTIONS: Use typewriter or ball point pen. PLEASE PRESS FIRMLY and PRINT clearly. Please fill in blanks, underline or circle the correct answers. Send top three copies to Kansas Department of Health and Environment, Bureau of Water, Topeka, Kansas 66620-0001. Telephone: 913-296-5545. Send one to WATER WELL OWNER and retain one for your records.

OFFICE USE ONLY T R E W SEC. 1/4 1/4 1/4