

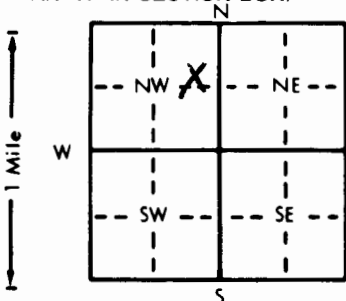
1 LOCATION OF WATER WELL:	Fraction	Section Number	Township Number	Range Number
County: <u>Saline</u>	<u>SE 1/4 NE 1/4 NW 1/4</u>	<u>36</u>	T <u>14</u> S <u>3</u>	R <u>2</u> E <u>W</u>

Distance and direction from nearest town or city street address of well if located within city?

517 E. Parkway3

2 WATER WELL OWNER:	RR#, St. Address, Box #	Board of Agriculture, Division of Water Resources
City, State, ZIP Code	<u>Salina Kansas 67401</u>	Application Number:

3 LOCATE WELL'S LOCATION WITH AN "X" IN SECTION BOX:	4 DEPTH OF COMPLETED WELL	ft. ELEVATION:
--	---------------------------	----------------

Depth(s) Groundwater Encountered 15 ft. 2. 15 ft. 3. 15 ft.WELL'S STATIC WATER LEVEL 15 ft. below land surface measured on mo/day/yr 6-22-96Pump test data: Well water was 16 ft. after 1 hours pumping 15 gpmEst. Yield 30 gpm: Well water was 16 ft. after 1 hours pumping 15 gpmBore Hole Diameter 8 1/2 in. to 20 ft., and 5 1/2 in. to 50 ft.

WELL WATER TO BE USED AS:

1 Domestic	3 Feedlot	6 Oil field water supply	8 Air conditioning	11 Injection well
2 Irrigation	4 Industrial	7 Lawn and garden only	9 Dewatering	12 Other (Specify below)

Was a chemical/bacteriological sample submitted to Department? Yes No X; If yes, mo/day/yr sample was submittedWater Well Disinfected? Yes X No

5 TYPE OF BLANK CASING USED:	5 Wrought iron	8 Concrete tile	CASING JOINTS: Glued <u>X</u> Clamped
1 Steel	3 RMP (SR)	6 Asbestos-Cement	9 Other (specify below)
2 PVC	4 ABS	7 Fiberglass	Welded
Blank casing diameter <u>5</u> in. to <u>40</u> ft., Dia			Threaded

Casing height above land surface 20 in., weight 160 lb., Wall thickness or gauge No. SDR26

TYPE OF SCREEN OR PERFORATION MATERIAL:	10 Asbestos-cement
1 Steel	8 RMP (SR)
2 Brass	9 ABS
3 Stainless steel	11 Other (specify)
4 Galvanized steel	12 None used (open hole)

SCREEN OR PERFORATION OPENINGS ARE:	5 Gauzed wrapped	8 Saw cut	11 None (open hole)
1 Continuous slot	6 Wire wrapped	9 Drilled holes	
2 Louvered shutter	7 Torch cut	10 Other (specify)	
3 Mill slot			
4 Key punched			

SCREEN-PERFORATED INTERVALS:	From <u>40</u> ft. to <u>50</u> ft., From <u>50</u> ft. to <u>50</u> ft.
GRAVEL PACK INTERVALS:	From <u>20</u> ft. to <u>50</u> ft., From <u>50</u> ft. to <u>50</u> ft.

6 GROUT MATERIAL:	1 Neat cement	2 Cement grout	3 Bentonite	4 Other
Grout Intervals: From <u>0</u> ft. to <u>20</u> ft., From <u>20</u> ft. to <u>50</u> ft., From <u>50</u> ft. to <u>50</u> ft.				

What is the nearest source of possible contamination:

1 Septic tank	4 Lateral lines	7 Pit privy	10 Livestock pens	14 Abandoned water well
2 Sewer lines	5 Cess pool	8 Sewage lagoon	11 Fuel storage	15 Oil well/Gas well
3 Watertight sewer lines	6 Seepage pit	9 Feedyard	12 Fertilizer storage	16 Other (specify below)

Direction from well? West How many feet? 15'

FROM	TO	LITHOLOGIC LOG	FROM	TO	PLUGGING INTERVALS
0'	4'	Compacted silt + Top soil			
4'	12'	clay (Brown)			
12'	28'	FINE SAND + BROWN clay mixed			
28'	29'	clay <del>dark</del> DARK grey			
29'	50'	FINE TO medium SAND			
50'		clay (Brown)			

7 CONTRACTOR'S OR LANDOWNER'S CERTIFICATION: This water well was <u>1</u> constructed, (2) reconstructed, or (3) plugged under my jurisdiction and was completed on (mo/day/year) <u>6-24-96</u> and this record is true to the best of my knowledge and belief. Kansas Water Well Contractor's License No. <u>523</u> This Water Well Record was completed on (mo/day/yr) <u>6-24-96</u> under the business name of <u>M+D Well Service</u> by (signature) <u>Matthew Sank</u>
---