


1 LOCATION OF WATER WELL: County: SALINE Fraction: NW 1/4 SE 1/4 NW 1/4 Section Number: 19 Township Number: T 140 Range Number: R 2

Distance and direction from nearest town or city street address of well if located within city?
1414 Meyer Dr

2 WATER WELL OWNER: Ed Howie
 RR#, St. Address, Box #: 1414 Meyer Dr
 City, State, ZIP Code: SALINA KANSAS 67401
 Board of Agriculture, Division of Water Resources
 Application Number:

3 LOCATE WELL'S LOCATION WITH AN "X" IN SECTION BOX:
 4 DEPTH OF COMPLETED WELL: 52 ft. ELEVATION: 1226
 Depth(s) Groundwater Encountered 1. 19 ft. 2. 20 ft. 3. 29 ft.
 WELL'S STATIC WATER LEVEL: 19 ft. below land surface measured on mo/day/yr 9-29-96
 Pump test data: Well water was 19 ft. after 1 hours pumping 15 gpm
 Est. Yield 50 gpm: Well water was 19 ft. after 1 hours pumping 50 gpm
 Bore Hole Diameter: 8 1/2 in. to 26 ft., and 5 1/2 in. to 52 ft.

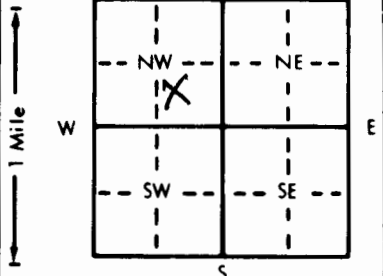

WELL WATER TO BE USED AS:
 5 Public water supply 8 Air conditioning 11 Injection well
 1 Domestic 3 Feedlot 6 Oil field water supply 9 Dewatering 12 Other (Specify below)
 2 Irrigation 4 Industrial 7 Lawn and garden only 10 Monitoring well
 Was a chemical/bacteriological sample submitted to Department? Yes X No X; If yes, mo/day/yr sample was submitted
 Water Well Disinfected? Yes X No

5 TYPE OF BLANK CASING USED:
 1 Steel 3 RMP (SR) 5 Wrought iron 8 Concrete tile CASING JOINTS: Glued X Clamped
2 PVC 4 ABS 7 Fiberglass Welded
 Blank casing diameter 5 in. to 42 ft., Dia. 160 LB lbs./ft. Wall thickness or gauge No. SDR26
 Casing height above land surface 16 in., weight 160 LB lbs./ft. Wall thickness or gauge No. SDR26
 TYPE OF SCREEN OR PERFORATION MATERIAL:
 1 Steel 3 Stainless steel 5 Fiberglass 8 RMP (SR) 11 Other (specify)
 2 Brass 4 Galvanized steel 6 Concrete tile 9 ABS 12 None used (open hole)

SCREEN OR PERFORATION OPENINGS ARE:
 1 Continuous slot 3 Mill slot 5 Gauzed wrapped 8 Saw cut 11 None (open hole)
 2 Louvered shutter 4 Key punched 6 Wire wrapped 9 Drilled holes
 7 Torch cut 10 Other (specify)
 SCREEN-PERFORATED INTERVALS: From 42 ft. to 52 ft., From 21 ft. to 52 ft.
 GRAVEL PACK INTERVALS: From 21 ft. to 52 ft., From 21 ft. to 52 ft.

6 GROUT MATERIAL: 1 Neat cement 2 Cement grout 3 Bentonite 4 Other
 Grout Intervals: From 0 ft. to 21 ft., From 21 ft. to 52 ft., From 21 ft. to 52 ft.
 What is the nearest source of possible contamination:
 1 Septic tank 4 Lateral lines 7 Pit privy 10 Livestock pens 14 Abandoned water well
 2 Sewer lines 5 Cess pool 8 Sewage lagoon 11 Fuel storage 15 Oil well/Gas well
3 Watertight sewer lines 6 Seepage pit 9 Feedyard 12 Fertilizer storage 16 Other (specify below)
 13 Insecticide storage
 Direction from well? EAST How many feet? 35

FROM	TO	LITHOLOGIC LOG	FROM	TO	PLUGGING INTERVALS
0'	2'	Fill dirt (compacted)			
2'	5'	Dark clay			
5'	26'	Brown clay			
26'	29'	Medium sand			
29'	38'	Grey clay + coarse sand mixed			
38'	52'	Coarse sand and gravel			
52'		Shale			

7 CONTRACTOR'S OR LANDOWNER'S CERTIFICATION: This water well was 0 constructed, (2) reconstructed, or (3) plugged under my jurisdiction and was completed on (mo/day/year) 9-29-96 and this record is true to the best of my knowledge and belief. Kansas Water Well Contractor's License No. 523 This Water Well Record was completed on (mo/day/yr) 9-30-96 under the business name of M & D Well Service by (signature) Matthew Laney

INSTRUCTIONS: Use typewriter or ball point pen. PLEASE PRESS FIRMLY and PRINT clearly. Please fill in blanks, underline or circle the correct answers. Send top three copies to Kansas Department of Health and Environment, Bureau of Water, Topeka, Kansas 66620-0001. Telephone: 913-296-5545. Send one to WATER WELL OWNER and retain one for your records.

OFFICE USE ONLY