


1 LOCATION OF WATER WELL: Fraction NE 1/4 SE 1/4 SW 1/4 Section Number 30 Township Number T 14 S Range Number R 2 E W

Distance and direction from nearest town or city street address of well if located within city?
 2250 A-Marie CT

2 WATER WELL OWNER: Greg Bixby
 RR#, St. Address, Box # 2250 A MARIE CT
 City, State, ZIP Code: SALINA, KS 67401
 Board of Agriculture, Division of Water Resources
 Application Number: _____

3 LOCATE WELL'S LOCATION WITH AN "X" IN SECTION BOX: 4 DEPTH OF COMPLETED WELL 49' ft. ELEVATION: 1232

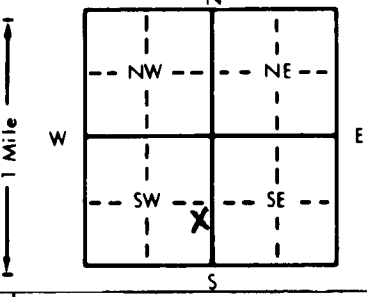

Depth(s) Groundwater Encountered 1. 16' 16' ft. 2. ft. 3. ft.
 WELL'S STATIC WATER LEVEL 16' 16' ft. below land surface measured on mo/day/yr 4-7-01
 Pump test data: Well water was 16' ft. after 1 hours pumping 15 gpm
 Est. Yield 40 gpm; Well water was ft. after hours pumping gpm
 Bore Hole Diameter 8 1/2 in. to 21 in. and 5 1/2 in. to 49 in.
 WELL WATER TO BE USED AS:
 1 Domestic 3 Feedlot 6 Oil field water supply 8 Air conditioning 11 Injection well
 2 Irrigation 4 Industrial 7 Lawn and garden only 10 Monitoring well 12 Other (Specify below)
 Is a chemical/bacteriological sample submitted to Department? Yes No X; If yes, mo/day/yr sample was submitted _____
 Water Well Disinfected? Yes X No

5 TYPE OF BLANK CASING USED:
 1 Steel 3 RMP (SR) 5 Wrought iron 8 Concrete tile CASING JOINTS: Glued X Clamped X
 2 PVC 4 ABS 6 Asbestos-Cement 9 Other (specify below) Welded _____
 7 Fiberglass Threaded _____

Blank casing diameter 5 in. to 39 in. Dia _____ in. to _____ in. to _____ in.
 Casing height above land surface 16 in., weight 160 LBS lbs./ft. Wall thickness or gauge No. SDR 2.6

TYPE OF SCREEN OR PERFORATION MATERIAL:
 1 Steel 3 Stainless steel 5 Fiberglass 8 RMP (SR) 11 Other (specify) _____
 2 Brass 4 Galvanized steel 6 Concrete tile 9 ABS 12 None used (open hole)

SCREEN OR PERFORATION OPENINGS ARE:
 1 Continuous slot 3 Mill slot 5 Gauzed wrapped 7 Saw cut 11 None (open hole)
 2 Louvered shutter 4 Key punched 6 Wire wrapped 9 Drilled holes
 7 Torch cut 10 Other (specify) _____

SCREEN-PERFORATED INTERVALS: From 39 ft. to 49 ft., From _____ ft. to _____ ft.
 GRAVEL PACK INTERVALS: From 21 ft. to 39 ft., From _____ ft. to _____ ft.

6 GROUT MATERIAL: 1 Neat cement 2 Cement grout 3 Bentonite 4 Other _____
 Grout Intervals: From 0 ft. to 21 ft., From _____ ft. to _____ ft., From _____ ft. to _____ ft.

What is the nearest source of possible contamination:
 1 Septic tank 4 Lateral lines 7 Pit privy 10 Livestock pens 14 Abandoned water well
 2 Sewer lines 5 Cess pool 8 Sewage lagoon 11 Fuel storage 15 Oil well/Gas well
 3 Watertight sewer lines 6 Seepage pit 9 Feedyard 12 Fertilizer storage 16 Other (specify below)
 13 Insecticide storage
 Direction from well? EAST How many feet? 45'

| FROM | TO | LITHOLOGIC LOG | FROM | TO | PLUGGING INTERVALS |
|------|-----|--------------------------------|------|----|--------------------|
| 0' | 2' | FILL DIRT | | | |
| 2' | 4' | DARK BR CLAY | | | |
| 4' | 11' | LT. BR CLAY | | | |
| 11' | 14' | FINE SAND | | | |
| 14' | 21' | CLAY & FINE SAND MIXED | | | |
| 21' | 32' | SAND FINE | | | |
| 32' | 36' | DARK GREY CLAY | | | |
| 36' | 49' | MEDIUM TO COARSE SAND & GRAVEL | | | |

7 CONTRACTOR'S OR LANDOWNER'S CERTIFICATION: This water well was (1) constructed, (2) reconstructed, or (3) plugged under my jurisdiction and was completed on (mo/day/year) 4-7-01 and this record is true to the best of my knowledge and belief. Kansas Water Well Contractor's License No. 523 This Water Well Record was completed on (mo/day/yr) 4-11-01 under the business name of M&D Well Service by (signature) Matthew Janney

OFFICE USE ONLY
 T
 R
 SEC.
 1/4
 1/4
 1/4