

CORRECTION TO WATER WELL RECORD (WWC-5)

The following correction(s) was made to the attached WWC-5 log, in order to file the item or to rectify lacking or incorrect information.

Fraction (1/4 1/4 1/4) Section-Township-Range changed:

listed as SE SE SE, 25-14S-2

changed to SE SW SW, 30-14S-2W

Other changes: Initial statements: 2318 Linden Lane

Changed to: 2318 Linden Dr.

Comments: _____

verification method: Well address, well owner's address on internet,
city map, and Salina 1:24,000 topo map. initials: DRG date: 5/29/2002

submitted by: Kansas Geological Survey, Data Resources Library, 1930 Constant Ave., Lawrence, KS 66047-3726
to: Kansas Dept of Health & Environment Bureau of Water Industrial Programs, Bldg 283, Forbes Field, KS 66620


1 LOCATION OF WATER WELL: County: SALINE Fraction SE 1/4 SE 1/4 SE 1/4 Section Number 25 Township Number T 14 S Range Number R 2 EW

Distance and direction from nearest town or city street address of well if located within city?

2318 LINDEN LANE

2 WATER WELL OWNER: LARRY GOODWIN RR#, St. Address, Box #: 2318 LINDEN LANE City, State, ZIP Code: SALINA, KS. 67401 Board of Agriculture, Division of Water Resources Application Number:

3 LOCATE WELL'S LOCATION WITH AN 'X' IN SECTION BOX: 4 DEPTH OF COMPLETED WELL: 49 ft. ELEVATION: 1230

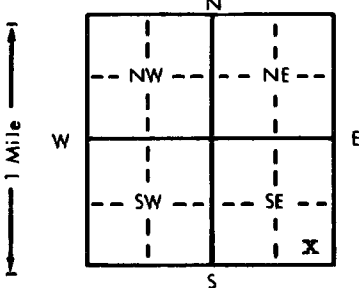

Depth(s) Groundwater Encountered 1. 12.10 ft. 2. ft. 3. ft. WELL'S STATIC WATER LEVEL 12.10 ft. below land surface measured on mo/day/yr 5-12-98 Pump test data: Well water was 13.4 ft. after 1 hours pumping 30 gpm Est. Yield 7.5+ gpm: Well water was ft. after hours pumping gpm Bore Hole Diameter 9 in. to 49 ft. and in. to ft. WELL WATER TO BE USED AS: 5 Public water supply 8 Air conditioning 11 Injection well 1 Domestic 3 Feedlot 6 Oil field water supply 9 Dewatering 12 Other (Specify below) 2 Irrigation 4 Industrial 7 Lawn and garden only 10 Monitoring well Was a chemical/bacteriological sample submitted to Department? Yes No X If yes, mo/day/yr sample was submitted Water Well Disinfected? Yes X No

5 TYPE OF BLANK CASING USED: 1 Steel 3 RMP (SR) 5 Wrought iron 8 Concrete tile CASING JOINTS: Glued X Clamped Welded Threaded 2 PVC 4 ABS 6 Asbestos-Cement 9 Other (specify below) Blank casing diameter 5 in. to 39 ft., Dia. 12 in. to 160 lbs./ft. Wall thickness or gauge No. SDR 26 TYPE OF SCREEN OR PERFORATION MATERIAL: 1 Steel 3 Stainless steel 5 Fiberglass 8 RMP (SR) 10 Asbestos-cement 2 Brass 4 Galvanized steel 6 Concrete tile 9 ABS 11 Other (specify) 12 None used (open hole) SCREEN OR PERFORATION OPENINGS ARE: 1 Continuous slot 3 Mill slot .025 5 Gauzed wrapped 8 Saw cut 11 None (open hole) 2 Louvered shutter 4 Key punched 6 Wire wrapped 9 Drilled holes 10 Other (specify) SCREEN-PERFORATED INTERVALS: From 39 ft. to 49 ft. GRAVEL PACK INTERVALS: From 30 ft. to 49 ft.

6 GROUT MATERIAL: 1 Neat cement 2 Cement grout 3 Bentonite 4 Other Grout Intervals: From 0 ft. to 24 ft. What is the nearest source of possible contamination: 1 Septic tank 4 Lateral lines 7 Pit privy 10 Livestock pens 14 Abandoned water well 2 Sewer lines 5 Cess pool 8 Sewage lagoon 11 Fuel storage 15 Oil well/Gas well 3 Watertight sewer lines 6 Seepage pit 9 Feedyard 12 Fertilizer storage 16 Other (specify below) 13 Insecticide storage Direction from well? WEST How many feet? 30

Table with columns: FROM, TO, LITHOLOGIC LOG, FROM, TO, PLUGGING INTERVALS. Rows include: 0 to 2: FILL DIRT; 2 to 18: SANDY LOAM; 18 to 49: SAND FINE TO MED. TAN

7 CONTRACTOR'S OR LANDOWNER'S CERTIFICATION: This water well was (1) constructed, (2) reconstructed, or (3) plugged under my jurisdiction and was completed on (mo/day/year) 5-12-98 and this record is true to the best of my knowledge and belief. Kansas Water Well Contractor's License No. 308 This Water Well Record was completed on (mo/day/yr) 5-12-98 under the business name of PESTINGER PUMP SERVICE by (signature) Paul Pestinger

INSTRUCTIONS: Use typewriter or ball point pen. PLEASE PRESS FIRMLY and PRINT clearly. Please fill in blanks, underline or circle the correct answers. Send top three copies to Kansas Department of Health and Environment, Bureau of Water, Topeka, Kansas 66620-0001. Telephone: 913-296-5545. Send one to WATER WELL OWNER and retain one for your records.

OFFICE USE ONLY T R E W SEC. 1/4 1/4 1/4