


1 LOCATION OF WATER WELL: Fraction NW 1/4 NE 1/4 SW 1/4 Section Number 19 Township Number T 14S Range Number R 2E  
 County: SALINE

Distance and direction from nearest town or city street address of well if located within city?  
1500 E. Minneapolis

2 WATER WELL OWNER: HARRY SEARLE  
 RR#, St. Address, Box #: 1500 E MINNEAPOLIS Board of Agriculture, Division of Water Resources  
 City, State, ZIP Code: SALINA, KS 67401 Application Number:

3 LOCATE WELL'S LOCATION WITH AN "X" IN SECTION BOX: 4 DEPTH OF COMPLETED WELL: 47 ft. ELEVATION: 1226

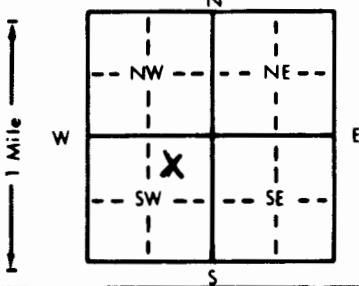

Depth(s) Groundwater Encountered 1. 18 ft. 2. . ft. 3. . ft.  
 WELL'S STATIC WATER LEVEL 18 ft. below land surface measured on mo/day/yr  
 Pump test data: Well water was 18 ft. after 1 hours pumping 15 gpm  
 Est. Yield 30 gpm; Well water was . ft. after . hours pumping . gpm  
 Bore Hole Diameter 8 1/2 in. to 18 ft., and . in. to . ft.  
 WELL WATER TO BE USED AS: 5 Public water supply 8 Air conditioning 11 Injection well  
 1 Domestic 3 Feedlot 6 Oil field water supply 9 Dewatering 12 Other (Specify below)  
 2 Irrigation 4 Industrial 2 Lawn and garden only 10 Monitoring well  
 Was a chemical/bacteriological sample submitted to Department? Yes. . No. X; If yes, mo/day/yr sample was submitted  
 Water Well Disinfected? Yes X No

5 TYPE OF BLANK CASING USED: 5 Wrought iron 8 Concrete tile CASING JOINTS: Glued X Clamped .  
 1 Steel 3 RMP (SR) 6 Asbestos-Cement 9 Other (specify below) Welded .  
2 PVC 4 ABS 7 Fiberglass Threaded .

Blank casing diameter 5 in. to 37 in. Dia. . in. to . ft. Dia. . in. to . ft.  
 Casing height above land surface . in. weight 100 LB lbs./ft. Wall thickness or gauge No. SDA 26

TYPE OF SCREEN OR PERFORATION MATERIAL: 7 PVC 10 Asbestos-cement  
 1 Steel 3 Stainless steel 5 Fiberglass 8 RMP (SR) 11 Other (specify) .  
 2 Brass 4 Galvanized steel 6 Concrete tile 9 ABS 12 None used (open hole)

SCREEN OR PERFORATION OPENINGS ARE: 5 Gauzed wrapped 8 Saw cut 11 None (open hole)  
 1 Continuous slot 3 Mill slot 6 Wire wrapped 9 Drilled holes  
 2 Louvered shutter 4 Key punched 7 Torch cut 10 Other (specify) .

SCREEN-PERFORATED INTERVALS: From 37 ft. to 47 ft., From . ft. to . ft.  
 From . ft. to . ft., From . ft. to . ft.  
 GRAVEL PACK INTERVALS: From 17 ft. to 47 ft., From . ft. to . ft.  
 From . ft. to . ft., From . ft. to . ft.

6 GROUT MATERIAL: 1 Neat cement 2 Cement grout 3 Bentonite 4 Other .  
 Grout Intervals: From 0 ft. to 17 ft., From . ft. to . ft., From . ft. to . ft.

What is the nearest source of possible contamination:  
 1 Septic tank 4 Lateral lines 7 Pit privy 10 Livestock pens 14 Abandoned water well  
 2 Sewer lines 5 Cess pool 8 Sewage lagoon 11 Fuel storage 15 Oil well/Gas well  
3 Watertight sewer lines 6 Seepage pit 9 Feedyard 12 Fertilizer storage 16 Other (specify below)  
 13 Insecticide storage  
 Direction from well? WEST + SOUTH How many feet? 30' + 20'

FROM	TO	LITHOLOGIC LOG	FROM	TO	PLUGGING INTERVALS
0'	7'	Brown-Grey clays			(Waived)
7'	11'	SAND (FINE) + clay mixed			TALKED TO DON
11'	13'	BROWN clay			Taylor about gravel
13'	34'	FINE SAND			depth of 17 FT
34'	47'	COARSE SAND + GRAVEL			ON 10-9-01

7 CONTRACTOR'S OR LANDOWNER'S CERTIFICATION: This water well was 1 constructed, (2) reconstructed, or (3) plugged under my jurisdiction and was completed on (mo/day/year) 10-9-01 and this record is true to the best of my knowledge and belief. Kansas Water Well Contractor's License No. 523 This Water Well Record was completed on (mo/day/yr) 10-9-01 under the business name of M&D Well Service by (signature) Matthew Louber

OFFICE USE ONLY  
 T  
 R  
 EW  
 SEC  
 1/4  
 1/4  
 1/4