


1 LOCATION OF WATER WELL: County: <b>SALINE</b>		Fraction <b>NW 1/4 SE 1/4 SW 1/4</b>	Section Number <b>19</b>	Township Number <b>T 14 S</b>	Range Number <b>R 2W E/W</b>
----------------------------------------------------	--	-----------------------------------------	-----------------------------	----------------------------------	---------------------------------

Distance and direction from nearest town or city street address of well if located within city?

**1550 AUSTIN CIRCLE**

2 WATER WELL OWNER: <b>CRAIG BOXLER</b>			Board of Agriculture, Division of Water Resources
RR#, St. Address, Box # : <b>1550 AUSTIN CIRCLE</b>		Application Number:	
City, State, ZIP Code : <b>SALINA, KS. 67401</b>			

3 LOCATE WELL'S LOCATION WITH AN "X" IN SECTION BOX:	4 DEPTH OF COMPLETED WELL ..... <b>49</b> ..... ft. ELEVATION: ..... <b>1230</b> .....			
	Depth(s) Groundwater Encountered 1 ..... <b>19</b> ..... ft. 2 ..... ..... ft. 3 ..... ..... ft. WELL'S STATIC WATER LEVEL ..... <b>19</b> ..... ft. below land surface measured on mo/day/yr ..... <b>8-5-02</b> ..... Pump test data: Well water was ..... <b>22</b> ..... ft. after ..... <b>1</b> ..... hours pumping ..... <b>25</b> ..... gpm Est. Yield ..... <b>75+</b> ..... gpm: Well water was ..... ..... ft. after ..... ..... hours pumping ..... ..... gpm WELL WATER TO BE USED AS: 5 Public water supply 8 Air conditioning 11 Injection well 1 Domestic 3 Feedlot 6 Oil field water supply 9 Dewatering 12 Other (Specify below) 2 Irrigation 4 Industrial <b>7 Domestic (lawn &amp; garden)</b> 10 Monitoring well .....			
Was a chemical/bacteriological sample submitted to Department? Yes ..... No <input checked="" type="checkbox"/> ..... If yes, mo/day/yrs sample was submitted ..... Water Well Disinfected? Yes <input checked="" type="checkbox"/> ..... No .....				

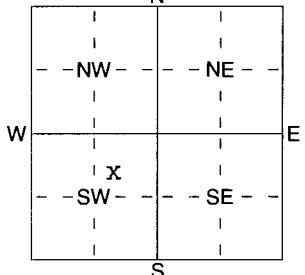

5 TYPE OF BLANK CASING USED:		5 Wrought iron	8 Concrete tile	CASING JOINTS: Glued <input checked="" type="checkbox"/> Clamped .....
1 Steel	3 RMP (SR)	6 Asbestos-Cement	9 Other (specify below)	Welded .....
2 PVC	4 ABS	7 Fiberglass		Threaded .....
Blank casing diameter ..... <b>5</b> ..... in. to ..... <b>43</b> ..... ft., Dia ..... in. to ..... ft., Dia ..... in. to ..... ft.				
Casing height above land surface ..... <b>16</b> ..... in., weight ..... <b>160</b> ..... lbs./ft. Wall thickness or gauge No. <b>SDR 26</b> .....				
TYPE OF SCREEN OR PERFORATION MATERIAL:				
1 Steel	3 Stainless Steel	5 Fiberglass	7 PVC	10 Asbestos-Cement
2 Brass	4 Galvanized Steel	6 Concrete tile	8 RMP (SR)	11 Other (Specify) .....
			9 ABS	12 None used (open hole)
SCREEN OR PERFORATION OPENINGS ARE:				
1 Continuous slot	3 Mill slot <b>.025</b>	5 Gauzed wrapped	8 Saw cut	11 None (open hole)
2 Louvered shutter	4 Key punched	6 Wire wrapped	9 Drilled holes	
		7 Torch cut	10 Other (specify) .....	ft.
SCREEN-PERFORATED INTERVALS: From ..... <b>43</b> ..... ft. to ..... <b>49</b> ..... ft., From ..... ft. to ..... ft., From ..... ft. to ..... ft.				
GRAVEL PACK INTERVALS: From ..... <b>22</b> ..... ft. to ..... <b>49</b> ..... ft., From ..... ft. to ..... ft., From ..... ft. to ..... ft.				

6 GROUT MATERIAL: 1 Neat cement 2 Cement grout 3 <u>Bentonite</u> 4 Other .....				
Grout Intervals: From ..... <b>0</b> ..... ft. to ..... <b>22</b> ..... ft., From ..... ft. to ..... ft., From ..... ft. to ..... ft.				
What is the nearest source of possible contamination:				
1 Septic tank	4 Lateral lines	7 Pit privy	10 Livestock pens	14 Abandoned water well
2 Sewer lines	5 Cess pool	8 Sewage lagoon	11 Fuel storage	15 Oil well/Gas well
3 <u>Watertight sewer lines</u>	6 Seepage pit	9 Feedyard	12 Fertilizer storage	16 Other (specify below)
Direction from well? <b>EAST</b>		How many feet? <b>45</b>		

FROM	TO	LITHOLOGIC LOG	FROM	TO	PLUGGING INTERVALS
0	3	FILL DIRT			
3	19	SANDY LOAM TAN			
19	49	SAND FINE TO MED. TAN			
49	53	GRAVEL HEAVY			

7 CONTRACTOR'S OR LANDOWNER'S CERTIFICATION: This water well was (1) constructed, (2) reconstructed, or (3) plugged under my jurisdiction and was completed on (mo/day/year) ..... <b>8-5-02</b> ..... and this record is true to the best of my knowledge and belief. Kansas Water Well Contractor's Licence No ..... <b>388</b> ..... This Water Well Record was completed on (mo/day/yr) ..... <b>8-9-02</b> ..... under the business name of <b>PESTINGER PUMP SERVICE</b> by (signature) <i>Paul Pestinger</i>		
---	--	--

INSTRUCTIONS: Use typewriter or ball point pen. PLEASE PRESS FIRMLY and PRINT clearly. Please fill in blanks, underline or circle the correct answers. Send top three copies to Kansas Department of Health and Environment, Bureau of Water, Geology Section, 1000 SW Jackson St., Suite 420, Topeka, Kansas 66612-1367. Telephone 785-296-5522. Send one to WATER WELL OWNER and retain one for your records. Fee of \$5.00 for each constructed well.