


1 LOCATION OF WATER WELL: Fraction SE 1/4 SW 1/4 SW 1/4 Section Number 19 Township Number T 14 0 Range Number R 2 04
 County: SALINE

Distance and direction from nearest town or city street address of well if located within city?
1401 AUSTIN

2 WATER WELL OWNER: Lee Frederikson
 RR#, St. Address, Box #: 1401 AUSTIN Cir Board of Agriculture, Division of Water Resources
 City, State, ZIP Code: Salina, KANSAS 67401 Application Number:

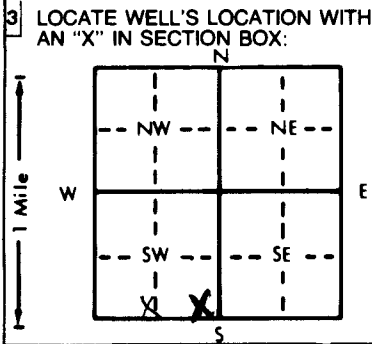

4 DEPTH OF COMPLETED WELL: 50 ft. ELEVATION: 1230
 Depth(s) Groundwater Encountered 1. 22 ft. 2. _____ ft. 3. _____ ft.
 WELL'S STATIC WATER LEVEL: 22 ft. below land surface measured on mo/day/yr 6-13-04
 Pump test data: Well water was 22 ft. after 1 hours pumping 15 gpm
 Est. Yield 50 gpm; Well water was _____ ft. after _____ hours pumping _____ gpm
 Bore Hole Diameter: 7 1/2 in. to 22 in., and 5 1/2 in. to 50 in.
 WELL WATER TO BE USED AS:
 5 Public water supply 8 Air conditioning 11 Injection well
 1 Domestic 3 Feedlot 6 Oil field water supply 9 Dewatering 12 Other (Specify below)
 2 Irrigation 4 Industrial 7 Lawn and garden only 10 Monitoring well
 Was a chemical/bacteriological sample submitted to Department? Yes _____ No X; If yes, mo/day/yr sample was submitted _____
 Water Well Disinfected? Yes X No _____

5 TYPE OF BLANK CASING USED:
 1 Steel 3 RMP (SR) 5 Wrought iron 8 Concrete tile CASING JOINTS: Glued X Clamped _____
2 PVC 4 ABS 7 Fiberglass _____ Welded _____
 Blank casing diameter 5 in. to 36 in. Dia. _____ in. to _____ ft. Dia. _____ in. to _____ ft.
 Casing height above land surface 17 in., weight 160 LBS. lbs./ft. Wall thickness or gauge No. SDR26
 TYPE OF SCREEN OR PERFORATION MATERIAL:
 1 Steel 3 Stainless steel 5 Fiberglass 8 RMP (SR) 10 Asbestos-cement
 2 Brass 4 Galvanized steel 6 Concrete tile 9 ABS 11 Other (specify) _____
 12 None used (open hole)
 SCREEN OR PERFORATION OPENINGS ARE:
 1 Continuous slot 3 Mill slot 5 Gauzed wrapped 8 Saw cut 11 None (open hole)
 2 Louvered shutter 4 Key punched 6 Wire wrapped 9 Drilled holes
 7 Torch cut 10 Other (specify) _____
 SCREEN-PERFORATED INTERVALS: From 36' ft. to 50' ft., From _____ ft. to _____ ft.
 From _____ ft. to _____ ft., From _____ ft. to _____ ft.
 GRAVEL PACK INTERVALS: From 0' ft. to 22' ft., From _____ ft. to _____ ft.
 From _____ ft. to _____ ft., From _____ ft. to _____ ft.

6 GROUT MATERIAL: 1 Neat cement 2 Cement grout 3 Bentonite 4 Other _____
 Grout Intervals: From 0 ft. to 22 ft., From _____ ft. to _____ ft., From _____ ft. to _____ ft.
 What is the nearest source of possible contamination:
 1 Septic tank 4 Lateral lines 7 Pit privy 10 Livestock pens 14 Abandoned water well
 2 Sewer lines 5 Cess pool 8 Sewage lagoon 11 Fuel storage 15 Oil well/Gas well
3 Watertight sewer lines 6 Seepage pit 9 Feedyard 12 Fertilizer storage 16 Other (specify below) _____
 13 Insecticide storage
 Direction from well? 60' How many feet? West

| FROM | TO | LITHOLOGIC LOG | FROM | TO | PLUGGING INTERVALS |
|------|-----|------------------------------|------|----|--------------------|
| 0' | 7' | Compact fill dirt & TOP SOIL | | | |
| 7' | 22' | BROWN CLAY | | | |
| 22' | 25' | Brown clay fine SAND mixed | | | |
| 25' | 32' | Medium SAND | | | |
| 32' | 35' | Grey clay & sand mix | | | |
| 35' | 50' | Coarse SAND & GRAVEL | | | |

7 CONTRACTOR'S OR LANDOWNER'S CERTIFICATION: This water well was 1 constructed, (2) reconstructed, or (3) plugged under my jurisdiction and was completed on (mo/day/year) 6-14-04 and this record is true to the best of my knowledge and belief. Kansas
 Water Well Contractor's License No. 523 This Water Well Record was completed on (mo/day/yr) 6-14-04
 under the business name of MHD Well Service by (signature) Matthew Louber

OFFICE USE ONLY