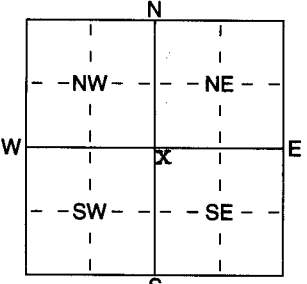


1 LOCATION OF WATER WELL: County: SALINE	Fraction NW 1/4 NW 1/4 SE 1/4	Section Number 19	Township Number T 14 S	Range Number R 2W E/W
--	---	-----------------------------	----------------------------------	---------------------------------

Distance and direction from nearest town or city street address of well if located within city?
1222 REPUBLIC CIRCLE

2 WATER WELL OWNER: **KEN DECHANT**
 RR#, St. Address, Box # : **1222 REPUBLIC CIRCLE**
 City, State, ZIP Code : **SALINA, KS. 67401**
 Board of Agriculture, Division of Water Resources
 Application Number:

3 LOCATE WELL'S LOCATION WITH AN "X" IN SECTION BOX: 	4 DEPTH OF COMPLETED WELL 50 ft. ELEVATION: 1228 Depth(s) Groundwater Encountered 21 ft. 2 ft. 3 ft. WELL'S STATIC WATER LEVEL 21 ft. below land surface measured on 7-14-04 mo/day/yr Pump test data: Well water was 25 ft. after 1 hours pumping 20 gpm Est. Yield 7.5 gpm: Well water was ft. after hours pumping gpm WELL WATER TO BE USED AS: 1 Domestic 3 Feedlot 5 Public water supply 8 Air conditioning 11 Injection well 2 Irrigation 4 Industrial 6 Oil field water supply 9 Dewatering 12 Other (Specify below) 7 Domestic (lawn & garden) 10 Monitoring well Was a chemical/bacteriological sample submitted to Department? Yes No <input checked="" type="checkbox"/>; If yes, mo/day/yr sample was submitted Water Well Disinfected? Yes <input checked="" type="checkbox"/> No
--	---

5 TYPE OF BLANK CASING USED:
 1 Steel 3 RMP (SR) 5 Wrought iron 8 Concrete tile CASING JOINTS: Glued Clamped
 2 PVC 4 ABS 6 Asbestos-Cement 9 Other (specify below) Welded
 7 Fiberglass Threaded
 Blank casing diameter **5** in. to **4.5** ft., Dia in. to ft., Dia in. to ft.
 Casing height above land surface **14** in., weight **160** lbs./ft. Wall thickness or gauge No. **SDR 26**
 TYPE OF SCREEN OR PERFORATION MATERIAL:
 1 Steel 3 Stainless Steel 5 Fiberglass 7 PVC 10 Asbestos-Cement
 2 Brass 4 Galvanized Steel 6 Concrete tile 8 RMP (SR) 11 Other (Specify)
 9 ABS 12 None used (open hole)
 SCREEN OR PERFORATION OPENINGS ARE:
 1 Continuous slot 3 Mill slot **.025** 5 Gauzed wrapped 8 Saw cut 11 None (open hole)
 2 Louvered shutter 4 Key punched 6 Wire wrapped 9 Drilled holes
 7 Torch cut 10 Other (specify) ft.
 SCREEN-PERFORATED INTERVALS: From **45** ft. to **50** ft., From ft. to ft.
 GRAVEL PACK INTERVALS: From **21** ft. to **50** ft., From ft. to ft.
 From ft. to ft., From ft. to ft.

6 GROUT MATERIAL: **1 Neat cement w/ BEN. 2 Cement grout** 3 Bentonite 4 Other
 Grout Intervals: From **0** ft. to **21** ft., From ft. to ft., From ft. to ft.
 What is the nearest source of possible contamination:
 1 Septic tank 4 Lateral lines 7 Pit privy 10 Livestock pens 14 Abandoned water well
 2 Sewer lines 5 Cess pool 8 Sewage lagoon 11 Fuel storage 15 Oil well/Gas well
 3 Watertight sewer lines 6 Seepage pit 9 Feedyard 12 Fertilizer storage 16 Other (specify below)
 13 Insecticide storage
 Direction from well? **WEST 40** How many feet? **40**

FROM	TO	LITHOLOGIC LOG	FROM	TO	PLUGGING INTERVALS
0	3	FILL DIRT			
3	19	CLAY TAN SILTY			
19	50	SAND FINE TO MED. TAN			
50		SHALE GRAY			

7 CONTRACTOR'S OR LANDOWNER'S CERTIFICATION: This water well was (1) constructed, (2) reconstructed, or (3) plugged under my jurisdiction and was completed on (mo/day/year) **7-14-04** and this record is true to the best of my knowledge and belief. Kansas Water Well Contractor's Licence No **388** This Water Well Record was completed on (mo/day/yr) **7-14-04** under the business name of **PESTINGER PUMP SERVICE** by (signature) 