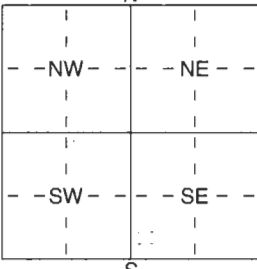


1 LOCATION OF WATER WELL: County: <u>SALINE</u>	Fraction <u>SW 1/4 SW 1/4 SE 1/4</u>	Section Number <u>30</u>	Township Number <u>T 14 S</u>	Range Number <u>R 2W E/W</u>
--	---	-----------------------------	----------------------------------	---------------------------------

Distance and direction from nearest town or city street address of well if located within city?

1518 EAGLECREST

2 WATER WELL OWNER: <u>JEFFREY DYKES</u> RR#, St. Address, Box # : <u>1518 EAGLECREST</u> City, State, ZIP Code : <u>SALINA, KS. 67401</u>	Board of Agriculture, Division of Water Resources Application Number:
--	--


3 LOCATE WELL'S LOCATION WITH AN "X" IN SECTION BOX: 	4 DEPTH OF COMPLETED WELL <u>50</u> ft. ELEVATION: <u>1231</u> Depth(s) Groundwater Encountered 1 <u>19</u> ft. 2 ft. 3 ft. WELL'S STATIC WATER LEVEL <u>19</u> ft. below land surface measured on mo/day/yr <u>9-24-04</u> Pump test data: Well water was <u>21</u> ft. after hours pumping <u>25</u> gpm Est. Yield <u>7.5+</u> gpm: Well water was ft. after hours pumping gpm WELL WATER TO BE USED AS: 1 Domestic 3 Feedlot 5 Public water supply 8 Air conditioning 11 Injection well 2 Irrigation 4 Industrial 6 Oil field water supply 9 Dewatering 12 Other (Specify below) 7 Domestic (lawn & garden) 10 Monitoring well
Was a chemical/bacteriological sample submitted to Department? Yes No <u>X</u> ; If yes, mo/day/yr sample was submitted Water Well Disinfected? Yes- No	

5 TYPE OF BLANK CASING USED: 1 Steel 3 RMP (SR) <u>2 PVC</u> 4 ABS	5 Wrought iron 8 Concrete tile 6 Asbestos-Cement 9 Other (specify below) 7 Fiberglass	CASING JOINTS: Glued Clamped Welded Threaded
Blank casing diameter <u>5</u> in. to <u>40</u> ft., Dia in. to ft., Dia in. to ft.	Casing height above land surface <u>16</u> in., weight <u>160</u> lbs./ft. Wall thickness or gauge No. <u>SDR 26</u>	
TYPE OF SCREEN OR PERFORATION MATERIAL: 1 Steel 3 Stainless Steel 5 Fiberglass 2 Brass 4 Galvanized Steel 6 Concrete tile	<u>7 PVC</u> 8 RMP (SR) 9 ABS	10 Asbestos-Cement 11 Other (Specify) 12 None used (open hole)
SCREEN OR PERFORATION OPENINGS ARE: 1 Continuous slot 2 Louvered shutter	<u>3 Mill slot .025</u> 4 Key punched	5 Gauzed wrapped 8 Saw cut 11 None (open hole) 6 Wire wrapped 9 Drilled holes 7 Torch cut 10 Other (specify)
SCREEN-PERFORATED INTERVALS: From <u>40</u> ft. to <u>50</u> ft., From ft. to ft.	GRAVEL PACK INTERVALS: From <u>22</u> ft. to <u>50</u> ft., From ft. to ft.	

6 GROUT MATERIAL: 1 Neat cement 2 Cement grout <u>3 Bentonite</u> 4 Other	Grout Intervals: From <u>0</u> ft. to <u>22</u> ft., From ft. to ft., From ft. to ft.
What is the nearest source of possible contamination: 1 Septic tank 4 Lateral lines 7 Pit privy 10 Livestock pens 14 Abandoned water well 2 Sewer lines 5 Cess pool 8 Sewage lagoon 11 Fuel storage 15 Oil well/Gas well 3 Watertight sewer lines 6 Seepage pit 9 Feedyard 12 Fertilizer storage 16 Other (specify below) 13 Insecticide storage	Direction from well? <u>EAST</u> How many feet? <u>60</u>

FROM	TO	LITHOLOGIC LOG	FROM	TO	PLUGGING INTERVALS
0	3	FILL DIRT			
3	18	CLAY GRAY			
18	36	SAND FINE GRAY WITH TREES WOOD			
36	50	SAND MED. TAN CLEAN			
50		CLAY GRAY			

RECEIVED
OCT 08 2004
BUREAU OF WATER

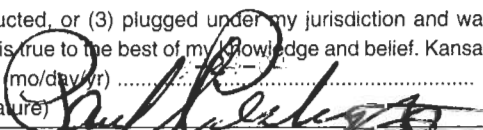7 CONTRACTOR'S OR LANDOWNER'S CERTIFICATION: This water well was (1) constructed, (2) reconstructed, or (3) plugged under my jurisdiction and was completed on (mo/day/year) <u>9-24-04</u> and this record is true to the best of my knowledge and belief. Kansas Water Well Contractor's Licence No <u>388</u> This Water Well Record was completed on (mo/day/yr) under the business name of <u>PESTINGER PUMP SERVICE</u> by (signature) 

INSTRUCTIONS: Use typewriter or ball point pen. PLEASE PRESS FIRMLY and PRINT clearly. Please fill in blanks, underline or circle the correct answers. Send to three copies to Kansas Department of Health and Environment, Bureau of Water, Geology Section, 1000 SW Jackson St., Suite 420, Topeka, Kansas 66612-1367. Telephone 785-296-5522. Send one to WATER WELL OWNER and retain one for your records. Fee of \$5.00 for each constructed well.