


1 LOCATION OF WATER WELL: County: SALINE Fraction: NE 1/4 SW 1/4 SW 1/4 Section Number: 19 Township Number: T 14 S Range Number: R 2 E W

Distance and direction from nearest town or city street address of well if located within city?

1445 AUSTIN

2 WATER WELL OWNER: RR#, St. Address, Box #: 1445 AUSTIN City, State, ZIP Code: SALINA KANSAS 67401 Board of Agriculture, Division of Water Resources Application Number: 1228

3 LOCATE WELL'S LOCATION WITH AN "X" IN SECTION BOX: 4 DEPTH OF COMPLETED WELL: 49 ft. ELEVATION: 1228

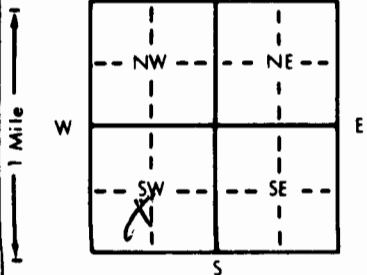

Depth(s) Groundwater Encountered 1. 22 ft. 2. 22 ft. 3. 22 ft.
 WELL'S STATIC WATER LEVEL 22 ft. below land surface measured on mo/day/yr 3-20-05
 Pump test data: Well water was 22 ft. after 1 hours pumping 15 gpm
 Est. Yield 50 gpm. Well water was 22 ft. after 1 hours pumping 15 gpm
 Bore Hole Diameter 8 1/2 in. to 22 ft., and 5 in. to 49 ft.
 WELL WATER TO BE USED AS:
 1 Domestic 3 Feedlot 5 Public water supply 8 Air conditioning 11 Injection well
 2 Irrigation 4 Industrial 6 Oil field water supply 9 Dewatering 12 Other (Specify below)
 7 Lawn and garden only 10 Monitoring well
 Was a chemical/bacteriological sample submitted to Department? Yes No If yes, mo/day/yr sample was submitted
 Water Well Disinfected? Yes No

5 TYPE OF BLANK CASING USED:
 1 Steel 3 RMP (SR) 5 Wrought iron 8 Concrete tile CASING JOINTS: Glued Clamped
 2 PVC 4 ABS 6 Asbestos-Cement 9 Other (specify below) Welded
 7 Fiberglass Threaded

Blank casing diameter 5 in. to 39 ft., Dia. 160 lbs./ft. Wall thickness or gauge No. SDR26
 Casing height above land surface 20 in.

TYPE OF SCREEN OR PERFORATION MATERIAL:
 1 Steel 3 Stainless steel 5 Fiberglass 7 RMP (SR) 10 Asbestos-cement
 2 Brass 4 Galvanized steel 6 Concrete tile 9 ABS 11 Other (specify)
 12 None used (open hole)

SCREEN OR PERFORATION OPENINGS ARE:
 1 Continuous slot 3 Mill slot 5 Gauzed wrapped 8 Saw cut 11 None (open hole)
 2 Louvered shutter 4 Key punched 6 Wire wrapped 9 Drilled holes
 7 Torch cut 10 Other (specify)

SCREEN-PERFORATED INTERVALS: From 39 ft. to 49 ft., From 22 ft. to 49 ft.
 GRAVEL PACK INTERVALS: From 22 ft. to 49 ft.

6 GROUT MATERIAL: 1 Neat cement 2 Cement grout 3 Bentonite 4 Other
 Grout Intervals: From 0 ft. to 22 ft., From 0 ft. to 22 ft.

What is the nearest source of possible contamination:
 1 Septic tank 4 Lateral lines 7 Pit privy 10 Livestock pens 14 Abandoned water well
 2 Sewer lines 5 Cess pool 8 Sewage lagoon 11 Fuel storage 15 Oil well/Gas well
 3 Watertight sewer lines 6 Seepage pit 9 Feedyard 12 Fertilizer storage 16 Other (specify below)
 13 Insecticide storage
 Direction from well? WEST How many feet? 40 FT

FROM	TO	LITHOLOGIC LOG	FROM	TO	PLUGGING INTERVALS
0'	3'	FILL DIRT			
3'	7'	TOPSOIL LT BR clay			
7'	21'	LT BR clay + FINE SAND MIX			
21'	23'	Grey clay			
23'	32'	Coarse SAND + Grey clay mix			
32'	49'	Medium TO coarse SAND			

7 CONTRACTOR'S OR LANDOWNER'S CERTIFICATION: This water well was constructed, reconstructed, or plugged under my jurisdiction and was completed on (mo/day/year) 3-20-05 and this record is true to the best of my knowledge and belief. Kansas Water Well Contractor's License No. 523 This Water Well Record was completed on (mo/day/yr) 3-26-05 under the business name of M-D Well Service by (signature) Matthew Soukup

INSTRUCTIONS: Use typewriter or ball point pen. PLEASE PRESS FIRMLY and PRINT clearly. Please fill in blanks, underline or circle the correct answers. Send top three copies to Kansas Department of Health and Environment, Bureau of Water, Topeka, Kansas 66620-0001. Telephone: 913-296-5545. Send one to WATER WELL OWNER and retain one for your records.

OFFICE USE ONLY
T
R
EW
SEC.
1/4
1/4
1/4