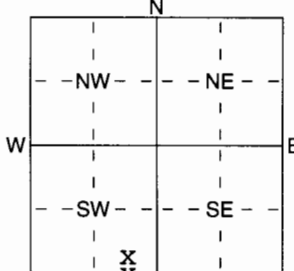


1 LOCATION OF WATER WELL:	Fraction	Section Number	Township Number	Range Number
County: SALINE	SW 1/4 SE 1/4 SW 1/4	19	T 14 S	R 2W E/W

Distance and direction from nearest town or city street address of well if located within city?

1541 AUSTIN CIRCLE


2 WATER WELL OWNER: BRENT RUPERT	Board of Agriculture, Division of Water Resources
RR#, St. Address, Box # : 1541 AUSTIN CIRCLE	Application Number:
City, State, ZIP Code : SALINA, KS. 67401	

3 LOCATE WELL'S LOCATION WITH AN "X" IN SECTION BOX:	4 DEPTH OF COMPLETED WELL 54 ft. ELEVATION: 1.230
	Depth(s) Groundwater Encountered 1 20 ft. 2 ft. 3 ft. WELL'S STATIC WATER LEVEL 20 ft. below land surface measured on mo/day/yr 6-7-05 Pump test data: Well water was 2.1 ft. after 1 hours pumping 20 gpm Est. Yield 5.0± gpm: Well water was ft. after hours pumping gpm WELL WATER TO BE USED AS: 5 Public water supply 8 Air conditioning 11 Injection well 1 Domestic 3 Feedlot 6 Oil field water supply 9 Dewatering 12 Other (Specify below) 2 Irrigation 4 Industrial 7 Domestic (lawn & garden) 10 Monitoring well
	Was a chemical/bacteriological sample submitted to Department? Yes No <input checked="" type="checkbox"/>; If yes, mo/day/yr sample was submitted Water Well Disinfected? Yes <input checked="" type="checkbox"/> No

5 TYPE OF BLANK CASING USED:	5 Wrought iron	8 Concrete tile	CASING JOINTS: Glued <input checked="" type="checkbox"/> Clamped
1 Steel	3 RMP (SR)	6 Asbestos-Cement	9 Other (specify below)
2 PVC	4 ABS	7 Fiberglass	Welded
Blank casing diameter 5 in. to 4.9 ft., Dia in. to ft., Dia in. to ft.			Threaded
Casing height above land surface 1.2 in., weight 1.60 lbs./ft. Wall thickness or gauge No. SDR-36			
TYPE OF SCREEN OR PERFORATION MATERIAL:	7 PVC	10 Asbestos-Cement	
1 Steel	3 Stainless Steel	5 Fiberglass	8 RMP (SR)
2 Brass	4 Galvanized Steel	6 Concrete tile	9 ABS
SCREEN OR PERFORATION OPENINGS ARE:	5 Guazed wrapped	8 Saw cut	11 None (open hole)
1 Continuous slot	3 Mill slot	6 Wire wrapped	9 Drilled holes
2 Louvered shutter	4 Key punched	7 Torch cut	10 Other (specify)
SCREEN-PERFORATED INTERVALS: From 49 ft. to 54 ft., From ft. to ft.			
GRAVEL PACK INTERVALS: From 22 ft. to 54 ft., From ft. to ft.			

6 GROUT MATERIAL:	1 Neat cement	2 Cement grout	3 Bentonite	4 Other
Grout Intervals: From 0 ft. to 22 ft., From ft. to ft., From ft. to ft.				
What is the nearest source of possible contamination:	1 Septic tank	4 Lateral lines	7 Pit privy	10 Livestock pens
	2 Sewer lines	5 Cess pool	8 Sewage lagoon	11 Fuel storage
	3 Watertight sewer lines	6 Seepage pit	9 Feedyard	12 Fertilizer storage
				13 Insecticide storage
Direction from well? WEST				14 Abandoned water well
				15 Oil well/Gas well
				16 Other (specify below)
				How many feet? 50

FROM	TO	LITHOLOGIC LOG	FROM	TO	PLUGGING INTERVALS
0	3	FILL DIRT			
3	23	CLAY BROWN SILTY			
23	54	SAND FINE TO MED. TAN			
54		SHALE GRAY			

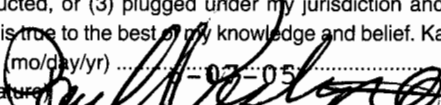7 CONTRACTOR'S OR LANDOWNER'S CERTIFICATION: This water well was (1) constructed, (2) reconstructed, or (3) plugged under my jurisdiction and was completed on (mo/day/year) 6-07-05 and this record is true to the best of my knowledge and belief. Kansas Water Well Contractor's Licence No 388 This Water Well Record was completed on (mo/day/yr) 07-05 under the business name of PESTINGER PUMP SERVICE by (signature) 

INSTRUCTIONS: Use typewriter or ball point pen. PLEASE PRESS FIRMLY and PRINT clearly. Please fill in blanks, underline or circle the correct answers. Send top three copies to Kansas Department of Health and Environment, Bureau of Water, Geology Section, 1000 SW Jackson St., Suite 420, Topeka, Kansas 66612-1367. Telephone 785-296-5522. Send one to WATER WELL OWNER and retain one for your records. Fee of \$5.00 for each constructed well.