


1 LOCATION OF WATER WELL: Fraction Section Number Township Number Range Number  
 County: Saline SW ¼ SE ¼ SW ¼ 17 14 2 **EW**

Distance and direction from nearest town or city street address of well if located within city?  
657 Fairdale, Salina

2 WATER WELL OWNER: Kwik Shop  
 RR #, St. Address, Box #: P.O. Box 1927 Board of Agriculture, Division of Water Resources  
 City, State, ZIP Code: Hutchinson, KS 67504-1927 Application Number:

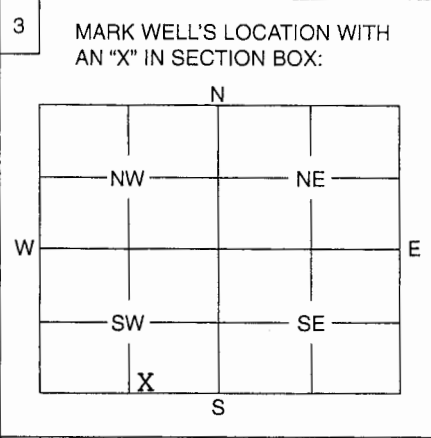

4 DEPTH OF WELL ..... 28.16 ..... ft. **BTOC**  
 WELL'S STATIC WATER LEVEL 24.62 ft. **BTOC**  
 WELL WAS USED AS:  
 1 Domestic 5 Public Water Supply 9 Dewatering  
 2 Irrigation 6 Oil Field Water Supply 10 **Monitoring Well**  
 3 Feedlot 7 Domestic (Lawn & Garden) 11 Injection Well  
 4 Industrial 8 Air Conditioning 12 Other .....

Was a chemical / bacteriological sample submitted to Department? Yes ..... No **X**.....  
 If yes, mo/day/yr sample was submitted .....

Water Well Disinfected: Yes ..... No **X**.....

5 TYPE OF BLANK CASING USED:  
 1 Steel 3 RMP (SR) 5 Wrought 7 Fiberglass 9 Other (Specify below)  
 2 **PVC** 4 ABS 6 Asbestos-Cement 8 Concrete Tile .....

Blank casing diameter ..... 2 ..... in. Was casing pulled? Yes **X**..... No ..... If yes, how much ..... 28'.....  
 Casing height above or below land surface ..... n/a ..... in.

6 GROUT PLUG MATERIAL: 1 Neat cement 2 Cement grout 3 **Bentonite** 4 Other Native soil  
 Grout Plug Intervals: From 0 ft. to 1 ft., From 1 ft. to 28 ft., From ..... to ..... ft.

What is the nearest source of possible contamination:  
 1 Septic tank 6 Seepage pit 11 Fuel storage 16 **Other (specify below)**  
 2 Sewer lines 7 Pit privy 12 Fertilizer storage UST basin  
 3 Watertight sewer lines 8 Sewage lagoon 13 Insecticide storage  
 4 Lateral lines 9 Feedyard 14 Abandoned water well  
 5 Cess pool 10 Livestock pens 15 Oil well/Gas well

Direction from well? ..... How many feet? .....

FROM	TO	PLUGGING MATERIALS
0	1	Native soil
1	20	Bentonite (8")
20	28	Bentonite (2")

MW10  
 KDHE #U5 085 10550  
 GeoCore #351

7 CONTRACTOR'S OF LANDOWNER'S CERTIFICATION: This water well was plugged under my jurisdiction and was completed on (mo/day/year) 2/27/2006 and this record is true to the best of my knowledge and belief. Kansas Water Well Contractor's License No. 527 This Water Well Record was completed on (mo/day/year) 2/28/2006 under the business name of GeoCore Inc.  
 by (signature) Oak Bell

INSTRUCTIONS: Use typewriter or ball point pen. Please press firmly and print clearly. Please fill in blanks, underline or circle the correct answers. Send top three copies to Kansas Department of Health and Environment, Bureau of Water, Geology Section, 1000 SW Jackson St., Ste. 420, Topeka, Kansas 66612-1367. Telephone: 785/296-5522. Send one to Water Well Owner and retain one for your records.