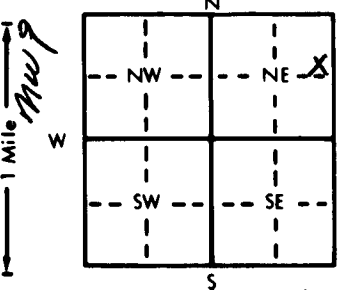


1 LOCATION OF WATER WELL: Fraction SE 1/4 NE 1/4 NE 1/4 Section Number 6 Township Number T 1 S 4 Range Number R 2 EW  
 County: Saline

Distance and direction from nearest town or city street address of well if located within city?  
East of Saline on old Hwy 40 to Marymount Rd north approx 1/2 mile

2 WATER WELL OWNER: Meshames  
 RR#, St. Address, Box #: 1835 E. North Street Board of Agriculture, Division of Water Resources  
 City, State, ZIP Code: Saline KS 67401 Application Number:

3 LOCATE WELL'S LOCATION WITH AN "X" IN SECTION BOX:  
  
 4 DEPTH OF COMPLETED WELL: 58 ft. ELEVATION:  
 Depth(s) Groundwater Encountered 1. 27 ft. 2. ft. 3. ft.  
 WELL'S STATIC WATER LEVEL ft. below land surface measured on mo/day/yr  
 Pump test data: Well water was ft. after hours pumping gpm  
 Est. Yield gpm: Well water was ft. after hours pumping gpm  
 Bore Hole Diameter: 4 in. to 22 ft., and 278 in. to 58 ft.  
 WELL WATER TO BE USED AS:  
 1 Domestic 3 Feedlot 6 Oil field water supply 9 Dewatering 12 Other (Specify below)  
 2 Irrigation 4 Industrial 7 Lawn and garden only 10 Monitoring well  
 Was a chemical/bacteriological sample submitted to Department? Yes No; If yes, mo/day/yr sample was submitted  
 Water Well Disinfected? Yes No

5 TYPE OF BLANK CASING USED:  
 1 Steel 3 RMP (SR) 5 Wrought iron 8 Concrete tile CASING JOINTS: Glued Clamped  
2 PVC 4 ABS 7 Fiberglass 9 Other (specify below) Welded  
 Blank casing diameter 1 in. to 43 ft., Dia. in. to ft., Dia. in. to ft.  
 Casing height above land surface 0 in., weight lbs./ft. Wall thickness or gauge No. Sch 80  
 TYPE OF SCREEN OR PERFORATION MATERIAL:  
 1 Steel 3 Stainless steel 5 Fiberglass 8 RMP (SR) 10 Asbestos-cement  
 2 Brass 4 Galvanized steel 6 Concrete tile 9 ABS 11 Other (specify)  
 12 None used (open hole)  
 SCREEN OR PERFORATION OPENINGS ARE:  
 1 Continuous slot 3 Mill slot 5 Gauzed wrapped 8 Saw cut 11 None (open hole)  
 2 Louvered shutter 4 Key punched 6 Wire wrapped 9 Drilled holes  
 7 Torch cut 10 Other (specify)  
 SCREEN-PERFORATED INTERVALS: From 43 ft. to 58 ft., From ft. to ft.  
 GRAVEL PACK INTERVALS: From 27 ft. to 58 ft., From ft. to ft.

6 GROUT MATERIAL: 1 Neat cement 2 Cement grout 3 Bentonite 4 Other  
 Grout Intervals: From 1 ft. to 27 ft., From ft. to ft.  
 What is the nearest source of possible contamination:  
 1 Septic tank 4 Lateral lines 7 Pit privy 10 Livestock pens 14 Abandoned water well  
 2 Sewer lines 5 Cess pool 8 Sewage lagoon 11 Fuel storage 15 Oil well/Gas well  
 3 Watertight sewer lines 6 Seepage pit 9 Feedyard 12 Fertilizer storage 16 Other (specify below)  
 13 Insecticide storage UNKNOWN

Direction from well? How many feet?

FROM	TO	LITHOLOGIC LOG	FROM	TO	PLUGGING INTERVALS
0	1	Top soil			
1	29	Silty clays			
29	58	Sands			

7 CONTRACTOR'S OR LANDOWNER'S CERTIFICATION: This water well was (1) constructed, (2) reconstructed, or (3) plugged under my jurisdiction and was completed on (mo/day/year) 4-28-06 and this record is true to the best of my knowledge and belief. Kansas Water Well Contractor's License No. 709 This Water Well Record was completed on (mo/day/yr) 5-18-06 under the business name of Plano Environmental Services by (signature) Jim Kalj

OFFICE USE ONLY  
T  
R  
EW  
SEC.  
1/4  
1/4  
1/4