

WATER WELL RECORD


Form WWC-5

Division of Water Resources; App. No.

Blank box for application number

1 LOCATION OF WATER WELL: County: Saline, Fraction: SW 1/4 SE 1/4 SW 1/4, Section Number: 30, Township Number: T 14 S, Range Number: R 2. Distance and direction from nearest town or city street address of well if located within city? City Limits- 2123 Huntington Salina, Ks.

2 WATER WELL OWNER: Kelly Dunn Construction, RR#, St. Address, Box #: 2550 Dundee Ln., City, State, ZIP Code: Salina, Ks. 67401. Global Positioning Systems (decimal degrees, min. of 4 digits) Latitude: Longitude: Elevation: Datum: Data Collection Method:

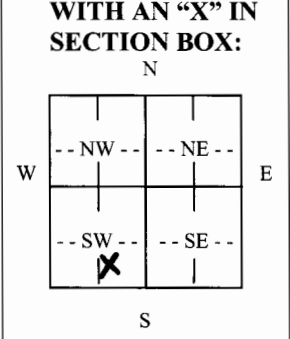

4 DEPTH OF COMPLETED WELL: 57 ft. Depth(s) Groundwater Encountered (1) 16 ft. (2) 30 ft. (3) 30 ft. WELL'S STATIC WATER LEVEL: 16 ft. below land surface measured on mo/day/yr: 4/18/07. Pump test data: Well water was 20-30 gpm. Est. Yield 20-30 gpm. WELL WATER TO BE USED AS: 5 Public water supply, 8 Air conditioning, 11 Injection well, 1 Domestic, 3 Feedlot, 6 Oil field water supply, 9 Dewatering, 12 Other (Specify below), 2 Irrigation, 4 Industrial, X Domestic (lawn & garden), 10 Monitoring well. Was a chemical/bacteriological sample submitted to Department? Yes No X; If yes, mo/day/yr Sample was submitted. Water well disinfected? Yes X No

5 TYPE OF CASING USED: 1 Steel, 3 RMP (SR), 6 Asbestos-Cement, 9 Other (specify below), X PVC, 4 ABS, 7 Fiberglass. CASING JOINTS: Glued X, Clamped, Welded, Threaded. Blank casing diameter: 5 in. to 47 ft., Diameter: 12 in. to 2.37 lbs./ft., Wall thickness or gauge No. 214. TYPE OF SCREEN OR PERFORATION MATERIAL: 1 Steel, 3 Stainless Steel, 5 Fiberglass, X PVC, 9 ABS, 11 Other (Specify), 2 Brass, 4 Galvanized Steel, 6 Concrete tile, 8 RM (SR), 10 Asbestos-Cement, 12 None used (open hole). SCREEN OR PERFORATION OPENINGS ARE: 1 Continuous slot, X Mill slot, 5 Guazed wrapped, 7 Torch cut, 9 Drilled holes, 11 None (open hole), 2 Louvered shutter, 4 Key punched, 6 Wire wrapped, 8 Saw Cut, 10 Other (specify). SCREEN-PERFORATED INTERVALS: From 47 ft. to 57 ft., From 20 ft. to 57 ft., GRAVEL PACK INTERVALS: From 20 ft. to 57 ft., From 20 ft. to 57 ft.

6 GROUT MATERIAL: 1 Neat cement, 2 Cement grout, X Bentonite, 4 Other. Grout Intervals: From 0 ft. to 20 ft., From 20 ft. to 100 ft., From 100 ft. to 100 ft. What is the nearest source of possible contamination: 1 Septic tank, 4 Lateral lines, 7 Pit privy, 10 Livestock pens, 13 Insecticide Storage, 16 Other (specify below), 2 Sewer lines, 5 Cess pool, 8 Sewage lagoon, 11 Fuel storage, 14 Abandoned water well, X Watertight sewer lines, 6 Seepage pit, 9 Feedyard, 12 Fertilizer Storage, 15 Oil well/gas well. Direction from well? West. How many feet? 100 ft.

Table with 6 columns: FROM, TO, LITHOLOGIC LOG, FROM, TO, PLUGGING INTERVALS. Rows include: 0-2 Topsoil, 2-13 Clay, gray, 13-26 Clay, soft, 26-54 Sands, fine to medium, 54-60 Shale, gray.

7 CONTRACTOR'S OR LANDOWNER'S CERTIFICATION: This water well was X constructed, (2) reconstructed, or (3) plugged under my jurisdiction and was completed on (mo/day/year) 4/20/07 and this record is true to the best of my knowledge and belief. Kansas Water Well Contractor's License No. 138. This Water Well Record was completed on (mo/day/year) 4/23/07 under the business name of Peterson Irrigation, Inc. by (signature) Mike Peterson

INSTRUCTIONS: Use typewriter or ball point pen. PLEASE PRESS FIRMLY and PRINT clearly. Please fill in blanks, underline or circle the correct answers. Send top three copies to Kansas Department of Health and Environment, Bureau of Water, Geology Section, 1000 SW Jackson St., Suite 420, Topeka, Kansas 66612-1367. Telephone 785-296-5522. Send one to WATER WELL OWNER and retain one for your records. Fee of \$5.00 for each constructed well. Visit us at http://www.kdhe.state.ks.us/geo/waterwells.