


1	LOCATION OF WATER WELL:	Fraction	Section Number	Township Number	Range Number
County:	Saline	SW 1/4 SW 1/4 SW 1/4	18	14 S	2 EW

Distance and direction from nearest town or city street address of well if located within city?
Near SE corner of Prescott Ave. & Ohio St.

2 WATER WELL OWNER: El Paso Merchant Energy

RR #, St. Address, Box #: 2 North Nevada Ave. Board of Agriculture, Division of Water Resources
City, State, ZIP Code : Colorado Springs, CO 80903 Application Number:

3	MARK WELL'S LOCATION WITH AN "X" IN SECTION BOX:	4	DEPTH OF WELL 29.15 ft. WELL'S STATIC WATER LEVEL 25.99 ft. WELL WAS USED AS: 1 Domestic 5 Public Water Supply 9 Dewatering 2 Irrigation 6 Oil Field Water Supply ● Monitoring Well 3 Feedlot 7 Domestic (Lawn & Garden) 11 Injection Well 4 Industrial 8 Air Conditioning 12 Other
---	--	---	---

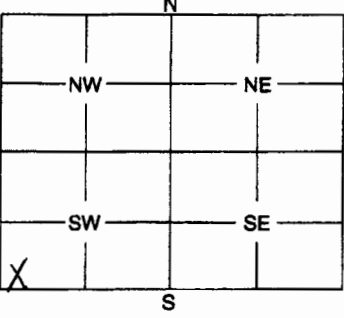

Was a chemical / bacteriological sample submitted to Department? Yes No
If yes, mo/day/yr sample was submitted

Water Well Disinfected: Yes No

5 TYPE OF BLANK CASING USED:

1 Steel 3 RMP (SR) 5 Wrought 7 Fiberglass 9 Other (Specify below)
● PVC 4 ABS 6 Asbestos-Cement 8 Concrete Tile

Blank casing diameter 2 in. Was casing pulled? Yes No If yes, how much 3'
Casing height above or below land surface 36 in.

6 GROUT PLUG MATERIAL: 1 Neat cement 2 Cement grout ● Bentonite 4 Other

Grout Plug Intervals: From 3 ft. to 29.15 ft., From ft. to ft., From to ft.

What is the nearest source of possible contamination:
1 Septic tank 6 Seepage pit ● Fuel storage 16 Other (specify below)
2 Sewer lines 7 Pit privy 12 Fertilizer storage
3 Watertight sewer lines 8 Sewage lagoon 13 Insecticide storage
4 Lateral lines 9 Feedyard 14 Abandoned water well
5 Cess pool 10 Livestock pens 15 Oil well/Gas well

Direction from well? S How many feet? 150'

FROM	TO	PLUGGING MATERIALS
0	3	Clay
3	29.15	Bentonite

MW9

7 CONTRACTOR'S OF LANDOWNER'S CERTIFICATION: This water well was plugged under my jurisdiction and was completed on (mo/day/year) 12/22/2008 and this record is true to the best of my knowledge and belief. Kansas Water Well Contractor's License No. 527 This Water Well Record was completed on (mo/day/year) 1/19/2009 under the business name of Geopora Inc.
by (signature) *Dale Bell*

INSTRUCTIONS: Use typewriter or ball point pen. Please press firmly and print clearly. Please fill in blanks, underline or circle the correct answers. Send top three copies to Kansas Department of Health and Environment, Bureau of Water, Geology Section, 1000 SW Jackson St., Ste. 420, Topeka, Kansas 66612-1367. Telephone: 785/296-5522. Send one to Water Well Owner and retain one for your records.