


WATER WELL RECORD Form WWC-5 KSA 82a-1212

1 LOCATION OF WATER WELL: Fraction NE 1/4 SW 1/4 NE 1/4 Section Number 7 Township Number T 14 S Range Number R 2 EW

Distance and direction from nearest town or city street address of well if located within city? 1835 E. North Street, Salina

2 WATER WELL OWNER: McShares, Inc. RR#, St. Address, Box #: 1835 E. North Street City, State, ZIP Code: Salina, Kansas 67401 Board of Agriculture, Division of Water Resources Application Number:

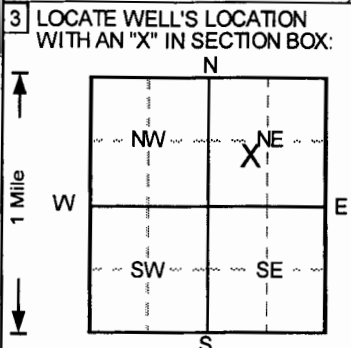

4 DEPTH OF COMPLETED WELL: 12 ft. ELEVATION: NA ft. below land surface measured on mo/day/yr. WELL'S STATIC WATER LEVEL: NA ft. below land surface. Pump test data: Well water was NA ft. after hours pumping gpm. Est. Yield NA gpm. Well water was ft. after hours pumping gpm. Bore Hole Diameter: 8 in. to 12 ft. WELL WATER TO BE USED AS: 10 Monitoring well. Was a chemical/bacteriological sample submitted to Department? Yes No. Water Well Disinfected? Yes No.

5 TYPE OF BLANK CASING USED: 2 PVC. Blank casing diameter: .2 in. to .6 ft. Dia. in. to ft. Dia. in. to ft. Casing height above land surface: 0 in., weight lbs./ft. Wall thickness or gauge No. Sch. 40. TYPE OF SCREEN OR PERFORATION MATERIAL: 7 PVC. SCREEN OR PERFORATION OPENINGS ARE: 3 Mill slot. SCREEN-PERFORATED INTERVALS: From 6 ft. to 12 ft. GRAVEL PACK INTERVALS: From 5 ft. to 12 ft.

6 GROUT MATERIAL: 2 Cement grout. 3 Bentonite. Grout intervals: From 0 ft. to 1 ft., From 1 ft. to 5 ft., From ft. to ft. What is the nearest source of possible contamination: 13 Insecticide storage. Direction from well? How many feet?

Table with columns: FROM, TO, LITHOLOGIC LOG, FROM, TO, PLUGGING INTERVALS. Rows include: 0 to 0.5 Concrete, 0.5 to 5 Silt, clayey, Brown, 5 to 7 Clay, v. silty, Brown to Lt. Brown, 7 to 12 Silt, clayey, Lt. Brown. Note: OBW-IS, Flushmount.

7 CONTRACTOR'S OR LANDOWNER'S CERTIFICATION: This water well was (1) constructed, (2) reconstructed, or (3) plugged under my jurisdiction and was completed on (mo/day/year) 3/8/2010 and this record is true to the best of my knowledge and belief. Kansas Water Well Contractor's License No. 527. This Water Well Record was completed on (mo/day/yr) 4/6/2010 under the business name of GeoCore, Inc. by (signature) Dale Hall.