


WATER WELL RECORD Form WWC-5 KSA 82a-1212

1 LOCATION OF WATER WELL: County: Saline Fraction NE 1/4 SW 1/4 NE 1/4 Section Number 7 Township Number T 14 S Range Number R 2 E

Distance and direction from nearest town or city street address of well if located within city? 1835 E. North St., Salina

2 WATER WELL OWNER: McShares, Inc. RR#, St. Address, Box #: 1835 E. North Street City, State, ZIP Code: Salina, Kansas 67401 Board of Agriculture, Division of Water Resources Application Number:

3 LOCATE WELL'S LOCATION WITH AN "X" IN SECTION BOX:

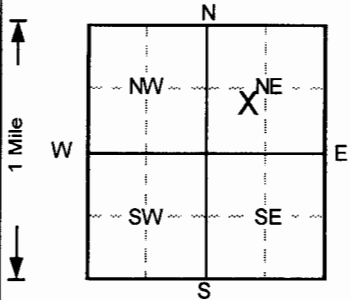

4 DEPTH OF COMPLETED WELL 28 ft ELEVATION: Depth(s) Groundwater Encountered 1. ft 2. ft 3. ft WELL'S STATIC WATER LEVEL ft below land surface measured on mo/day/yr Pump test data: Well water was NA ft after hours pumping gpm Est. Yield NA gpm: Well water was ft after hours pumping gpm Bore Hole Diameter 12 in. to 28.5 ft, and in. to ft WELL WATER TO BE USED AS: 5 Public water supply 8 Air conditioning 11 Injection well 1 Domestic 3 Feedlot 6 Oil field water supply 9 Dewatering 12 Other (Specify below) 2 Irrigation 4 Industrial 7 Lawn and garden only 10 Monitoring Well Soil vapor extractio. Was a chemical/bacteriological sample submitted to Department? Yes No checked; If yes, mo/day/yr sample was submitted Water Well Disinfected? Yes No checked

5 TYPE OF BLANK CASING USED: 1 Steel 2 PVC 3 RMP (SR) 4 ABS 5 Wrought iron 6 Asbestos-Cement 7 Fiberglass 8 Concrete tile 9 Other (specify below) CASING JOINTS: Glued Clamped Welded Threaded checked Blank casing diameter 4 in. to 18 ft, Dia in. to ft, Dia in. to ft Casing height above land surface in, weight lbs./ft. Wall thickness or gauge No. Sch. 40

TYPE OF SCREEN OR PERFORATION MATERIAL: 1 Steel 2 Brass 3 Stainless steel 4 Galvanized steel 5 Fiberglass 6 Concrete tile 7 PVC 8 RMP (SR) 9 ABS 10 Asbestos-cement 11 Other (specify) 12 None used (open hole)

SCREEN OR PERFORATION OPENINGS ARE: 1 Continuous slot 2 Louvered shutter 3 Mill slot 4 Key punched 5 Gauzed wrapped 6 Wire wrapped 7 Torch cut 8 Saw cut 9 Drilled holes 10 Other (specify) 11 None (open hole)

SCREEN-PERFORATED INTERVALS: From 18 ft to 28 ft, From ft to ft, From ft to ft GRAVEL PACK INTERVALS: From 16 ft to 28.5 ft, From ft to ft, From ft to ft

6 GROUT MATERIAL: 1 Neat cement 2 Cement grout 3 Bentonite 4 Other Grout Intervals: From 0 ft to 3 ft, From 3 ft to 16 ft, From ft to ft What is the nearest source of possible contamination: 1 Septic tank 2 Sewer lines 3 Watertight sewer lines 4 Lateral lines 5 Cess pool 6 Seepage pit 7 Pit privy 8 Sewage lagoon 9 Feedyard 10 Livestock pens 11 Fuel storage 12 Fertilizer storage 13 Insecticide storage 14 Abandoned water well 15 Oil well/Gas well 16 Other (specify below) Direction from well? How many feet?

Table with columns: FROM, TO, LITHOLOGIC LOG, FROM, TO, PLUGGING INTERVALS. Rows include: 0-0.5 Topsoil, w/sand, gravel fill, Brown; 0.5-5 Silt, sandy, Med. Brown; 5-7 Clay, Med. Brown; 7-15 Silt, clayey, Med. Brown; 15-26 Silt, clayey to sandy, Lt. Brown; 26-28.5 Sand, f-m, silty to sl. clayey, Tan; SVE-3D, Flushmount

7 CONTRACTOR'S OR LANDOWNER'S CERTIFICATION: This water well was (1) constructed, (2) reconstructed, or (3) plugged under my jurisdiction and was completed on (mo/day/year) 8/18/2010 and this record is true to the best of my knowledge and belief. Kansas Water Well Contractor's License No. 527 This Water Well Record was completed on (mo/day/yr) 8/24/2010 under the business name of GeoCore, Inc. by (signature) [Signature]

INSTRUCTIONS: Use typewriter or ball point pen. PLEASE PRESS FIRMLY and PRINT clearly. Please fill in blanks, underline or circle the correct answers. Send top three copies to Kansas Department of Health and Environment, Bureau of Water, Topeka, Kansas 66620-0001. Telephone: 913-296-5545. Send one to WATER WELL OWNER and retain one for your records.