


1 LOCATION OF WATER WELL: Fraction SW 1/4 SE 1/4 NE 1/4 Section Number 9 Township Number T 14 S Range Number R 2 E **W**

Distance and direction from nearest town or city street address of well if located within city?  
 ~1000' W of Simpson Rd., N side of North St.

2 WATER WELL OWNER: Country Club Acres, LLC  
 RR#, St. Address, Box # : PO Box 1460 Board of Agriculture, Division of Water Resources  
 City, State, ZIP Code : Salina, KS 67402-1460 Application Number:

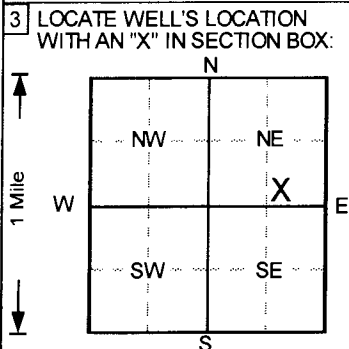

4 DEPTH OF COMPLETED WELL . . . . . 53 . . . . . ft. ELEVATION: . . . . . ft.  
 Depth(s) Groundwater Encountered 1. . . . . ft. 2. . . . . ft. 3. . . . . ft.  
 WELL'S STATIC WATER LEVEL . . . . . 14.5 . . . . . ft. below land surface measured on mo/day/yr . . . . . 4/6/2011  
 Pump test data: Well water was . . . . . NA . . . . . ft. after . . . . . hours pumping . . . . . gpm  
 Est. Yield . . . . . NA . . . . . gpm: Well water was . . . . . ft. after . . . . . hours pumping . . . . . gpm  
 Bore Hole Diameter . . . . . 9 . . . . . in. to . . . . . 56 . . . . . ft., and . . . . . in. to . . . . . ft.  
 WELL WATER TO BE USED AS: 5 Public water supply 8 Air conditioning 11 Injection well  
 1 Domestic 3 Feedlot 6 Oil field water supply 9 Dewatering **12 Other (Specify below)**  
 2 Irrigation 4 Industrial 7 Lawn and garden only 10 Monitoring well **Recovery well**  
 Was a chemical/bacteriological sample submitted to Department? Yes.....No  ; If yes, mo/day/yr sample was submitted  
 Water Well Disinfected? Yes No

5 TYPE OF BLANK CASING USED: 5 Wrought iron 8 Concrete tile CASING JOINTS: Glued . . . . . Clamped . . . . .  
 1 Steel 3 RMP (SR) 6 Asbestos-Cement 9 Other (specify below) Welded . . . . .  
**2 PVC** 4 ABS 7 Fiberglass Threaded.   
 Blank casing diameter . . . . . 5 . . . . . in. to . . . . . 33 . . . . . ft., Dia . . . . . in. to . . . . . ft., Dia . . . . . in. to . . . . . ft.  
 Casing height above land surface . . . . . 36 . . . . . in., weight . . . . . lbs./ft. Wall thickness or gauge No. . . . . Sch. 40  
 TYPE OF SCREEN OR PERFORATION MATERIAL **7 PVC** 10 Asbestos-cement  
 1 Steel 3 Stainless steel 5 Fiberglass 8 RMP (SR) 11 Other (specify) . . . . .  
 2 Brass 4 Galvanized steel 6 Concrete tile 9 ABS 12 None used (open hole)  
 SCREEN OR PERFORATION OPENINGS ARE: 5 Gauzed wrapped 8 Saw cut 11 None (open hole)  
 1 Continuous slot **3 Mill slot** 6 Wire wrapped 9 Drilled holes  
 2 Louvered shutter 4 Key punched 7 Torch cut 10 Other (specify) . . . . .  
 SCREEN-PERFORATED INTERVALS: From . . . . . 33 . . . . . ft. to . . . . . 53 . . . . . ft., From . . . . . ft. to . . . . . ft.  
 From . . . . . ft. to . . . . . ft., From . . . . . ft. to . . . . . ft.  
 GRAVEL PACK INTERVALS: From . . . . . 22 . . . . . ft. to . . . . . 56 . . . . . ft., From . . . . . ft. to . . . . . ft.  
 From . . . . . ft. to . . . . . ft., From . . . . . ft. to . . . . . ft.

6 GROUT MATERIAL: 1 Neat cement 2 Cement grout **3 Bentonite** 4 Other . . . . .  
 Grout Intervals: From . . . . . 1 . . . . . ft. to . . . . . 22 . . . . . ft., From . . . . . ft. to . . . . . ft., From . . . . . ft. to . . . . . ft.  
 What is the nearest source of possible contamination:  
 1 Septic tank 4 Lateral lines 7 Pit privy 10 Livestock pens 14 Abandoned water well  
 2 Sewer lines 5 Cess pool 8 Sewage lagoon 11 Fuel storage 15 Oil well/Gas well  
 3 Watertight sewer lines 6 Seepage pit 9 Feedyard 12 Fertilizer storage **16 Other (specify below)**  
 13 Insecticide storage **Unknown**  
 Direction from well? How many feet?

FROM	TO	LITHOLOGIC LOG	FROM	TO	PLUGGING INTERVALS
0	6	Clay, Dark Brown			
6	24	Clay, slty, vf sand, plastic, Brown			
24	28	Sand, vf-c, subrounded, Brown-Black			
28	34	Clay, silty, Gray w/Brown			
34	46	Sand, vf-c w/f gravel, Brown-Black			
46	52	Clay, v. silty, sl. sandy, Yellow Brown			
52	53	Sand, f-c w/f gravel, Brown and Black			
53	53.5	Clay, v. silty, Yellow Brown			
53.5	54.5	Sand, as above,			
54.5	55	Clay, v. silty, V. Lt. Gray			
55	56	Sand, f-c w/f gravel,			
					RW3 , Abovegrade

7 CONTRACTOR'S OR LANDOWNER'S CERTIFICATION: This water well was **(1)** constructed, (2) reconstructed, or (3) plugged under my jurisdiction and was completed on (mo/day/year) . . . . . 4/6/2011 . . . . . and this record is true to the best of my knowledge and belief.  
 Kansas Water Well Contractor's License No. . . . . 527 . . . . . This Water Well Record was completed on (mo/day/yr) . . . . . 4/24/2011 . . . . .  
 under the business name of **GeoCore, Inc.** by (signature) *Dan Bell*