


WATER WELL RECORD

Form WWC-5

Division of Water Resources App. No.

<p>1 LOCATION OF WATER WELL: County: <u>SALINE</u> Street/Rural Address of Well Location; if unknown, distance & direction from nearest town or intersection: If at owner's address, check here <input checked="" type="checkbox"/> <u>1513 AUSTIN CIRCLE</u></p>	<p>Fraction <u>NW 1/4 SW 1/4 SE 1/4 SW 1/4</u></p>	<p>Section Number <u>19</u></p>	<p>Township No. <u>T 14 S</u></p>	<p>Range Number <u>R 2</u> <input type="checkbox"/> E <input checked="" type="checkbox"/> W</p>
<p>2 WATER WELL OWNER: <u>DARREN BAENHART</u> RR#, Street Address, Box #: <u>1513 AUSTIN CIRCLE</u> City, State, ZIP Code: <u>SALINA, KS 67401</u></p>		<p>Global Positioning System (GPS) information: Latitude: (in decimal degrees) Longitude: (in decimal degrees) Elevation: Datum: <input type="checkbox"/> WGS 84, <input type="checkbox"/> NAD 83, <input type="checkbox"/> NAD 27 Collection Method: <input type="checkbox"/> GPS unit (Make/Model:) <input type="checkbox"/> Digital Map/Photo, <input type="checkbox"/> Topographic Map, <input type="checkbox"/> Land Survey Est. Accuracy: <input type="checkbox"/> <3 m, <input type="checkbox"/> 3-5 m, <input type="checkbox"/> 5-15 m, <input type="checkbox"/> >15 m</p>		

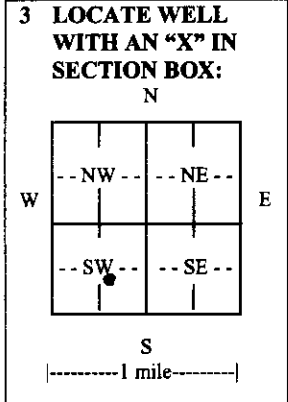

4 DEPTH OF COMPLETED WELL 53 ft.

Depth(s) Groundwater Encountered (1) 19 ft. (2) ft. (3) ft.

WELL'S STATIC WATER LEVEL 19 ft. below land surface measured on mo/day/yr 09-27-12

Pump test data: Well water was 20 ft. after 1 hours pumping 20 gpm

EST. YIELD gpm Well water was ft. after hours pumping gpm

Bore Hole Diameter 9 in. to 53 ft., and in. to ft.

WELL WATER TO BE USED AS: Public water supply Geothermal Injection well
 Domestic Feedlot Oil field water supply Dewatering Other (Specify below)
 Irrigation Industrial Domestic-lawn & garden Monitoring well

Was a chemical/bacteriological sample submitted to Department? Yes No

If yes, mo/day/yr sample was submitted.....

Water well disinfected? Yes No

5 TYPE OF CASING USED: Steel PVC Other

CASING JOINTS: Glued Clamped Welded Threaded

Casing diameter 5 in. to 47 ft., Diameter in. to ft., Diameter in. to ft.

Casing height above land surface 12 in., Weight 160 lbs./ft., Wall thickness or gauge No. SDR 26

TYPE OF SCREEN OR PERFORATION MATERIAL: Steel Stainless Steel PVC Other (Specify)

Brass Galvanized Steel None used (open hole)

SCREEN OR PERFORATION OPENINGS ARE:
 Continuous slot Mill slot, 0.25 Gauze wrapped Torch cut Drilled holes None (open hole)
 Louvered shutter Key punched Wire wrapped Saw cut Other (specify)

SCREEN-PERFORATED INTERVALS: From 47 ft. to 53 ft., From ft. to ft.

GRAVEL PACK INTERVALS: From 22 ft. to 53 ft., From ft. to ft.

6 GROUT MATERIAL: Neat cement Cement grout Bentonite Other

Grout Intervals: From 0 ft. to 22 ft., From ft. to ft., From ft. to ft.

What is the nearest source of possible contamination:
 Septic tank Lateral lines Pit privy Livestock pens Insecticide storage Other (specify below)
 Sewer lines Cesspool Sewage lagoon Fuel storage Abandoned water well
 Watertight sewer lines Seepage pit Feedyard Fertilizer storage Oil well/gas well

Direction from well .. NORTH Distance from well 30

FROM	TO	LITHOLOGIC LOG	FROM	TO	LITHO. LOG (cont.) or PLUGGING INTERVALS
<u>0</u>	<u>2</u>	<u>FILL DIRT</u>			
<u>2</u>	<u>11</u>	<u>CLAY BROWN SILTY</u>			
<u>11</u>	<u>32</u>	<u>SANDY LOAM GRAY</u>			
<u>32</u>	<u>52</u>	<u>SAND FINE TO MED. TAN</u>			
<u>52</u>	<u>53</u>	<u>CLAY GRAY</u>			

7 CONTRACTOR'S OR LANDOWNER'S CERTIFICATION: This water well was constructed, reconstructed, or plugged under my jurisdiction and was completed on (mo/day/year) 09-27-12 and this record is true to the best of my knowledge and belief. Kansas Water Well Contractor's License No. 388 This Water Well Record was completed on (mo/day/year) 09-27-12 under the business name of PESTING & PUMP SERVICE by (signature) Paul A. ...

INSTRUCTIONS: Use typewriter or ball point pen. PLEASE PRESS FIRMLY and PRINT clearly. Please fill in blanks and check the correct answers. Send three copies (white, blue, pink) to Kansas Department of Health and Environment, Bureau of Water, Geology Section, 1000 SW Jackson St., Suite 420, Topeka, Kansas 66612-1367. Telephone 785-296-5524. Send one copy to WATER WELL OWNER and retain one for your records. Include fee of \$5.00 for each constructed well. Visit us at <http://www.kdheks.gov/waterwell/index.html>.