

WATER WELL RECORD


Form WWC-5

Division of Water Resources App. No.

1 LOCATION OF WATER WELL: County: Saline Fraction 1/4 SE 1/4 SW 1/4 SE 1/4 Section Number 30 Township No. T 14 S Range Number R 2 E W

Street/Rural Address of Well Location; if unknown, distance & direction from nearest town or intersection: 1718 Eaglecrest, Salina, KS Global Positioning System (GPS) information: Latitude: Longitude: Elevation: Datum: Collection Method: GPS unit Digital Map/Photo Topographic Map Land Survey Est. Accuracy: <3 m 3-5 m 5-15 m >15 m

2 WATER WELL OWNER: Kelly Dunn Construction RR#, Street Address, Box #: 3059 Quail Creek Rd. City, State, ZIP Code : Salina, KS 67401

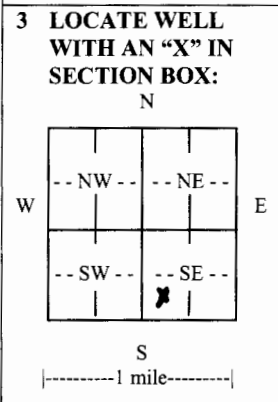

3 LOCATE WELL WITH AN 'X' IN SECTION BOX: N W E S |-----1 mile-----| 4 DEPTH OF COMPLETED WELL 52 ft. Depth(s) Groundwater Encountered (1) 20 ft. (2) ft. (3) ft. WELL'S STATIC WATER LEVEL 20 ft. below land surface measured on mo/day/yr 9/11/12 Pump test data: Well water was ft. after hours pumping gpm EST. YIELD 35-50 gpm Well water was ft. after hours pumping gpm Bore Hole Diameter 9 in. to 52 ft. and in. to ft. WELL WATER TO BE USED AS: Public water supply Geothermal Injection well Domestic Feedlot Oil field water supply Dewatering Other (Specify below) Irrigation Industrial Domestic-lawn & garden Monitoring well Was a chemical/bacteriological sample submitted to Department? Yes No If yes, mo/day/yr sample was submitted. Water well disinfected? Yes No

5 TYPE OF CASING USED: Steel PVC Other CASING JOINTS: Glued Clamped Welded Threaded Casing diameter 5 in. to 42 ft., Diameter in. to ft., Diameter in. to ft. Casing height above land surface 12 in., Weight 2.37 lbs./ft., Wall thickness or gauge No. 214 TYPE OF SCREEN OR PERFORATION MATERIAL: Steel Stainless Steel PVC Other (Specify) Brass Galvanized Steel None used (open hole) SCREEN OR PERFORATION OPENINGS ARE: Continuous slot Mill slot Gauze wrapped Torch cut Drilled holes None (open hole) Louvered shutter Key punched Wire wrapped Saw cut Other (specify) SCREEN-PERFORATED INTERVALS: From 42 ft. to 52 ft., From ft. to ft., From ft. to ft. GRAVEL PACK INTERVALS: From 20 ft. to 52 ft., From ft. to ft., From ft. to ft.

6 GROUT MATERIAL: Neat cement Cement grout Bentonite Other Grout Intervals: From 0 ft. to 20 ft., From ft. to ft., From ft. to ft. What is the nearest source of possible contamination: Septic tank Lateral lines Pit privy Livestock pens Insecticide storage Other (specify below) Sewer lines Cesspool Sewage lagoon Fuel storage Abandoned water well Watertight sewer lines Seepage pit Feedyard Fertilizer storage Oil well/gas well Direction from well North Distance from well 150'

Table with 6 columns: FROM, TO, LITHOLOGIC LOG, FROM, TO, LITHO. LOG (cont.) or PLUGGING INTERVALS. Rows include Topsoil (0-2), Clay, brown (2-18), Sand, fine to medium (18-51), and Shale, gray (51-55).

7 CONTRACTOR'S OR LANDOWNER'S CERTIFICATION: This water well was constructed, reconstructed, or plugged under my jurisdiction and was completed on (mo/day/year) 9/11/12 and this record is true to the best of my knowledge and belief. Kansas Water Well Contractor's License No. 138 This Water Well Record was completed on (mo/day/year) 9/17/12 under the business name of Peterson Irrigation, Inc. by (signature) Mike Bellus

INSTRUCTIONS: Use typewriter or ball point pen. PLEASE PRESS FIRMLY and PRINT clearly. Please fill in blanks and check the correct answers. Send three copies (white, blue, pink) to Kansas Department of Health and Environment, Bureau of Water, Geology Section, 1000 SW Jackson St., Suite 420, Topeka, Kansas 66612-1367. Telephone 785-296-5524. Send one copy to WATER WELL OWNER and retain one for your records. Include fee of \$5.00 for each constructed well. Visit us at http://www.kdheks.gov/waterwell/index.html.