

# WATER WELL RECORD Form WWC-5

☒ Original Record ☐ Correction ☐ Change in Well Use

Division of Water  
Resources App. No.

Well ID

## 1 LOCATION OF WATER WELL:

County: SALINE

Fraction SE 1/4 NE 1/4 SE 1/4 NW 1/4

Section Number 30

Township Number T 14 S

Range Number R 2 E NW

## 2 WELL OWNER:

Last Name: LEONARD First: RUSTIN


Business: #4 WILDCAT CIRCLE

Address: #4 WILDCAT CIRCLE

City: SALINA State: KS ZIP: 67401

Street or Rural Address where well is located (if unknown, distance and direction from nearest town or intersection): If at owner's address, check here: ☒

## 3 LOCATE WELL WITH "X" IN SECTION BOX:

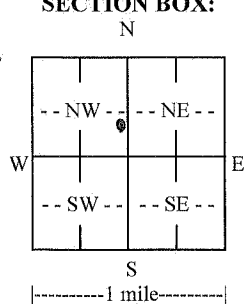

## 4 DEPTH OF COMPLETED WELL:

Depth(s) Groundwater Encountered: 1) 21 ft.  
2) 21 ft. 3) 21 ft. or 4) ☐ Dry Well  
WELL'S STATIC WATER LEVEL: 21 ft.  
☒ below land surface, measured on (mo-day-yr) 07-24-13  
☐ above land surface, measured on (mo-day-yr) 07-24-13  
Pump test data: Well water was 23 ft.  
after 1 hours pumping 20 gpm  
Well water was 23 ft.  
after 1 hours pumping 20 gpm  
Estimated Yield: 9 gpm  
Bore Hole Diameter: 9 in. to 58 ft. and 58 in. to 58 ft.

## 5 Latitude:

Longitude: (decimal degrees)

Datum: ☐ WGS 84 ☐ NAD 83 ☐ NAD 27

Source for Latitude/Longitude:

☐ GPS (unit make/model: )

(WAAS enabled? ☐ Yes ☐ No)

☐ Land Survey ☐ Topographic Map

☐ Online Mapper:

## 6 Elevation:

Source: ☐ Land Survey ☐ GPS ☐ Topographic Map

☐ Other

## 7 WELL WATER TO BE USED AS:

- |   |   |   |
|---|---|---|
| 1. Domestic:<br><input type="checkbox"/> Household<br><input checked="" type="checkbox"/> Lawn & Garden<br><input type="checkbox"/> Livestock | 5. <input type="checkbox"/> Public Water Supply: well ID<br>6. <input type="checkbox"/> Dewatering: how many wells?<br>7. <input type="checkbox"/> Aquifer Recharge: well ID<br>8. <input type="checkbox"/> Monitoring: well ID | 10. <input type="checkbox"/> Oil Field Water Supply: lease<br>11. Test Hole: well ID<br><input type="checkbox"/> Cased <input type="checkbox"/> Uncased <input type="checkbox"/> Geotechnical |
| 2. <input type="checkbox"/> Irrigation  | 9. Environmental Remediation: well ID<br><input type="checkbox"/> Air Sparge <input type="checkbox"/> Soil Vapor Extraction   | 12. Geothermal: how many bores?<br>a) Closed Loop <input type="checkbox"/> Horizontal <input type="checkbox"/> Vertical   |
| 3. <input type="checkbox"/> Feedlot   | <input type="checkbox"/> Recovery <input type="checkbox"/> Injection  | b) Open Loop <input type="checkbox"/> Surface Discharge <input type="checkbox"/> Inj. of Water  |
| 4. <input type="checkbox"/> Industrial  |   | 13. <input type="checkbox"/> Other (specify):   |

Was a chemical/bacteriological sample submitted to KDHE? ☐ Yes ☒ No If yes, date sample was submitted:

Water well disinfected? ☒ Yes ☐ No

## 8 TYPE OF CASING USED:

☐ Steel ☒ PVC ☐ Other CASING JOINTS: ☒ Glued ☐ Clamped ☐ Welded ☐ Threaded

Casing diameter 5 in. to 52 ft. Diameter 52 in. to 52 ft. Diameter 52 in. to 52 ft.

Casing height above land surface 16 in. Weight 140 lbs./ft. Wall thickness or gauge No. SDR 26

## TYPE OF SCREEN OR PERFORATION MATERIAL:

☐ Steel ☐ Stainless Steel ☐ Fiberglass ☒ PVC ☐ Other (Specify)

☐ Brass ☐ Galvanized Steel ☐ Concrete tile ☐ None used (open hole)

## SCREEN OR PERFORATION OPENINGS ARE:

☐ Continuous Slot ☒ Mill Slot 0.25 ☐ Gauze Wrapped ☐ Torch Cut ☐ Drilled Holes ☐ Other (Specify)

☐ Louvered Shutter ☐ Key Punched ☐ Wire Wrapped ☐ Saw Cut ☐ None (Open Hole)

SCREEN-PERFORATED INTERVALS: From 52 ft. to 58 ft. From 52 ft. to 58 ft. From 52 ft. to 58 ft.

GRAVEL PACK INTERVALS: From 22 ft. to 58 ft. From 22 ft. to 58 ft. From 22 ft. to 58 ft.

## 9 GROUT MATERIAL:

☐ Neat cement ☐ Cement grout ☒ Bentonite ☐ Other

Grout Intervals: From 0 ft. to 22 ft. From 22 ft. to 58 ft. From 22 ft. to 58 ft.

## Nearest source of possible contamination:

☐ Septic Tank ☐ Lateral Lines ☐ Pit Privy ☐ Livestock Pens ☒ Insecticide Storage

☐ Sewer Lines ☐ Cess Pool ☐ Sewage Lagoon ☐ Fuel Storage ☐ Abandoned Water Well

☒ Watertight Sewer Lines ☐ Seepage Pit ☐ Feedyard ☐ Fertilizer Storage ☐ Oil Well/Gas Well

☐ Other (Specify)

Direction from well? NORTH Distance from well? 400 ft.

## 10 FROM TO LITHOLOGIC LOG FROM TO LITHO. LOG (cont.) or PLUGGING INTERVALS

0	4	FINE DIRT			
4	18	CLAY BROWN FIRM			
18	29	SANDY LOAM TAN			
29	58	SANDY FINE TO MED TAN			
58		SHALE GRAY			

## 11 CONTRACTOR'S OR LANDOWNER'S CERTIFICATION:

This water well was ☒ constructed, ☐ reconstructed, or ☐ plugged under my jurisdiction and was completed on (mo-day-yr) 07-24-13 and this record is true to the best of my knowledge and belief.

Kansas Water Well Contractor's License No. 388 This Water Well Record was completed on (mo-day-yr) 07-24-13 under the business name of PESTINGED PUMP SERVICE

INSTRUCTIONS: Send one copy to WATER WELL OWNER and retain one copy for your records. Submit fee of \$5.00 for each constructed well along with one (white) copy to Kansas Department of Health and Environment, Bureau of Water, Geology Section, 1000 SW Jackson St., Suite 420, Topeka, Kansas 66612-1367. Telephone (785) 296-3565. Visit us at <http://www.kdheks.gov/waterwell/index.html>

KSA 82a-1212

Revised 9/10/2012