

County: Saline Fraction NE SW NE NW Sec. 16 T 14 S R 2 E (W)

CORRECTION(S) TO WATER WELL COMPLETION RECORD (WWC-5)

(to rectify lacking or incorrect information)

Owner: Exline Leasing, Inc.

Location was listed as:

Location changed to:

Section-Township-Range: _____

Fraction (1/4 1/4 1/4): _____

Other changes: Initial statements: Lat. : 97.5594

Long : 38.8392

Changed to: Lat. : 38.8392

Long : -97.55094

Comments: _____

Verification method: Wellsite address, city street map, latitude & longitude (corrected), and mapping tool & aerial photos on KGS website.

initials: DRL date: 10/7/2015

Submitted by: Kansas Geological Survey, Data Resources Library, 1930 Constant Ave., Lawrence, KS 66047-3726

to: Kansas Dept of Health & Environment, Bureau of Water, 1000 SW Jackson, Suite 420, Topeka, KS 66612-1367.

WATER WELL RECORD

Form WWC-5


Division of Water Resources App. No.

1 LOCATION OF WATER WELL: County: <u>Saline</u>	Fraction NE ¼ SW ¼ NE ¼ NW ¼	Section Number 16	Township No. T 14 S	Range Number R 2 <input type="checkbox"/> E <input checked="" type="checkbox"/> W
--	---------------------------------	----------------------	------------------------	--

Street/Rural Address of Well Location; if unknown, distance & direction
from nearest town or intersection: If at owner's address, check here
3256 East Country Club Road
Salina, KS 67401

2 WATER WELL OWNER:
RR#, Street Address, Box #: Exline Inc.
City, State, ZIP Code :

Global Positioning System (GPS) information:
Latitude: 37.5594 (in decimal degrees)
Longitude: 98.8392 (in decimal degrees)
Elevation: 1224.2
Datum: WGS 84, NAD 83, NAD 27
Collection Method:
 GPS unit (Make/Model: _____)
 Digital Map/Photo, Topographic Map, Land Survey
Est. Accuracy: <3 m, 3-5 m, 5-15 m, >15 m

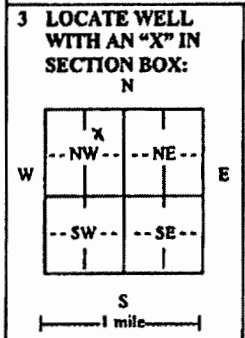

4 DEPTH OF COMPLETED WELL 7 ft.

Depth(s) Groundwater Encountered (1) NA ft. (2) _____ ft. (3) _____ ft.

WELL'S STATIC WATER LEVEL NA ft. below land surface measured on mo/day/yr. _____

Pump test data: Well water was _____ ft. after _____ hours pumping. _____ gpm

EST. YIELD _____ gpm. Well water was _____ ft. after _____ hours pumping. _____ gpm

Bore Hole Diameter 3 in. to 2 ft., and 2 in. to 7 ft.

WELL WATER TO BE USED AS: Public water supply Geothermal Injection well
 Domestic Feedlot Oil field water supply Dewatering Other (Specify below) Injection point
 Irrigation Industrial Domestic-lawn & garden Monitoring well

Was a chemical/bacteriological sample submitted to Department? Yes No
If yes, mo/day/yr sample was submitted. _____

Water well disinfected? Yes No

5 TYPE OF CASING USED: Steel PVC Other _____

CASING JOINTS: Glued Clamped Welded Threaded
Casing diameter 1 in. to 7 ft., Diameter _____ in. to _____ ft., Diameter _____ in. to _____ ft.
Casing height above land surface 24 in., Weight _____ lbs./ft., Wall thickness or gauge No. SCH 40

TYPE OF SCREEN OR PERFORATION MATERIAL:
 Steel Stainless Steel PVC Other (Specify) _____
 Brass Galvanized Steel None used (open hole)

SCREEN OR PERFORATION OPENINGS ARE:
 Continuous slot Mill slot Gauze wrapped Torch cut Drilled holes None (open hole)
 Louvered shutter Key punched Wire wrapped Saw cut Other (specify) _____

SCREEN-PERFORATED INTERVALS: From 2 ft. to 7 ft., From _____ ft. to _____ ft.
From _____ ft. to _____ ft., From _____ ft. to _____ ft.

GRAVEL PACK INTERVALS: From 2 ft. to 7 ft., From _____ ft. to _____ ft.
From _____ ft. to _____ ft., From _____ ft. to _____ ft.

6 GROUT MATERIAL: Neat cement Cement grout Bentonite Other _____

Grout Intervals: From 0 ft. to 2 ft., From _____ ft. to _____ ft., From _____ ft. to _____ ft.

What is the nearest source of possible contamination:
 Septic tank Lateral lines Pit privy Livestock pens Insecticide storage Other (specify below) Chromium Contam.
 Sewer lines Cesspool Sewage lagoon Fuel storage Abandoned water well
 Watertight sewer lines Seepage pit Feedyard Fertilizer storage Oil well/gas well

Direction from well _____ Distance from well _____

FROM		TO	LITHOLOGIC LOG	FROM		TO	LITHO. LOG (cont.) or PLUGGING INTERVALS
	0	1	Clay, silt				
	1	7	Clay, silt, sand				

7 CONTRACTOR'S OR LANDOWNER'S CERTIFICATION: This water well was constructed, reconstructed, or plugged under my jurisdiction and was completed on (mo/day/year) 11/15/13 and this record is true to the best of my knowledge and belief.
Kansas Water Well Contractor's License No. 709. This Water Well Record was completed on (mo/day/year) 12/30/13
under the business name of Plains Environmental Services, by (signature) *[Signature]*

INSTRUCTIONS: Use typewriter or ball point pen. PLEASE PRESS FIRMLY and PRINT clearly. Please fill in blanks and check the correct answers. Send one copy to Kansas Department of Health and Environment, Bureau of Water, Geology Section, 1000 SW Jackson St., Suite 420, Topeka, Kansas 66612-1367. Telephone 785-296-5524. Send one copy to WATER WELL OWNER and retain one for your records. Include fee of \$5.00 for each constructed well. Visit us at <http://www.kdheks.gov/waterwell/index.html>