


WATER WELL RECORD

Form WWC-5

Division of Water Resources; App. No.

1 LOCATION OF WATER WELL: Fraction NW 1/4 NW 1/4 NW 1/4 Section Number 19 Township Number T 14 S Range Number R 2 W
Distance and direction from nearest town or city street address of well if located within city? 1110 Faith Dr., Salina, KS Global Positioning System (decimal degrees, min. of 4 digits) Latitude: 38.82639° Longitude: 97.59361° Elevation: RIM: 1226.27; TOC: 1225.99 Datum: WGS84 Data Collection Method: legal survey

2 WATER WELL OWNER: Triplett, Inc. RR#, St. Address, Box #: PO Box 647 City, State, ZIP Code: Salina, KS 67402-0647

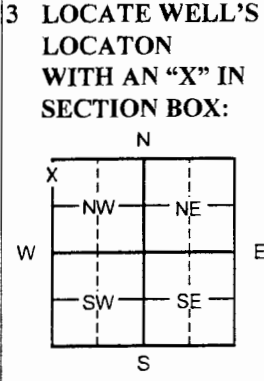

3 LOCATE WELL'S LOCATION WITH AN 'X' IN SECTION BOX: 4 DEPTH OF COMPLETED WELL 33.91 ft. MW4 Depth(s) Groundwater Encountered 1 ft. 2 ft. 3 ft. WELL'S STATIC WATER LEVEL 26.15 ft. below land surface measured on mo/day/yr 4/2/14 Pump test data: Well water was ft. after hours pumping gpm Est. Yield gpm: Well water was ft. after hours pumping gpm WELL WATER TO BE USED AS: 5 Public water supply 8 Air conditioning 11 Injection well 1 Domestic 3 Feed lot 6 Oil field water supply 9 Dewatering 12 Other (Specify below) 2 Irrigation 4 Industrial 7 Domestic (lawn & garden) (10) Monitoring well Was a chemical/bacteriological sample submitted to Department? Yes No X; If yes, mo/day/yr Sample was submitted Water Well Disinfected? Yes No X

5 TYPE OF CASING USED: 1 Steel 2 PVC 3 RMP (SR) 4 ABS 5 Wrought Iron 6 Asbestos-Cement 7 Fiberglass 8 Concrete tile 9 Other (specify below) CASING JOINTS: Glued Clamped Welded Threaded X Blank casing diameter 2 in. to 13.91 ft., Dia in. to ft., Dia in. to ft. Casing height below land surface 0.28 ft., Weight lbs./ft. Wall thickness or gauge No.

TYPE OF SCREEN OR PERFORATION MATERIAL: 1 Steel 2 Brass 3 Stainless steel 4 Galvanized steel 5 Fiberglass 6 Concrete tile 7 PVC 8 RM (SR) 9 ABS 10 Asbestos-Cement 11 Other (specify) 12 None used (open hole) SCREEN OR PERFORATION OPENINGS ARE: 1 Continuous slot 2 Louvered shutter 3 Mill slot 4 Key punched 5 Gauze wrapped 6 Wire wrapped 7 Torch cut 8 Saw Cut 9 Drilled holes 10 Other (specify) 11 None (open hole) SCREEN-PERFORATED INTERVALS: From 13.91 ft. to 33.91 ft. GRAVEL PACK INTERVALS: From 13 ft. to 34.25 ft.

6 GROUT MATERIAL: 1 Neat cement 2 Cement grout 3 Bentonite 4 Other Concrete: 0-1ft Grout Intervals From 1 ft. to 13 ft. From ft. to ft. From ft. to ft. What is the nearest source of possible contamination: 1 Septic tank 2 Sewer lines 3 Watertight sewer lines 4 Lateral lines 5 Cess pool 6 Seepage pit 7 Pit privy 8 Sewage lagoon 9 Feedyard 10 Livestock pens 11 Fuel storage 12 Fertilizer storage 13 Insecticide Storage 14 Abandoned water well 15 Oil well/ gas well 16 Other (specify below) Direction from well? NW How many feet? ~120'

Table with columns: FROM, TO, LITHOLOGIC LOG, FROM, TO, PLUGGING INTERVALS. Rows include: 0-15 Brown silty clay, 15-20 Brown fine sandy clay, 20-34.25 Medium sand. Includes a note: Flushmount waiver from BOW

7 CONTRACTOR'S OR LANDOWNER'S CERTIFICATION: This water well was (1) constructed, (2) reconstructed, or (3) plugged under my jurisdiction and was completed on (mo/day/year) 4/1/14 and this record is true to the best of my knowledge and belief. Kansas Water Well Contractor's License No. 757. This Water Well Record was completed on (mo/day/year) 5/1/14 under the business name of Larsen & Associates, Inc. by (signature)

INSTRUCTIONS: Please fill in blanks or circle the correct answers. Send top three copies to Kansas Department of Health and Environment, Bureau of Water, Geology Section, 1000 SW Jackson St., Suite 420, Topeka, Kansas 66612-1367. Telephone 785-296-5522. Send one to WATER WELL OWNER and retain one for your records. Fee of \$5.00 for each constructed well. Visit us at http://www.kdheks.gov/waterwell.

# TRITERRA

## LAND SERVICES

P.O. Box 546  
Clearwater, Kansas 67026  
Cell (316) 648-3617 Fax (620) 584-4371  
Email: triterrals@yahoo.com

### SURVEYING OF MONITORING WELLS EAST CRAWFORD AMOCO SALINA, KANSAS

All monitoring wells are located in the NW/4 Section 19, Township 14 South, Range 2 West of the Sixth Principal Meridian, Saline County, Kansas. The Northwest corner of Section 19 was assigned coordinates of 5280.00 North and 5280.00 West.

The top of casing elevation of CMW-13R from an adjacent site was used as vertical control. A control point was established as a chiseled 'X' on the northeast corner of the storm drain at the northwest corner of the site.

The Latitude and Longitude were recorded from a GPS unit. The site is located on the 7.5' quad map titled "Salina".

ID	NORTH	WEST	LATITUDE	LONGITUDE	ELEVATION
NW CORNER 19-14S-2W	5280.00	5280.00			
CP	5242.14	5203.89	38.82692	97.59383	1226.80
MW-1	5159.89	5207.48	38.82673	97.59384	RIM 1228.22 TOC 1227.68
MW-2 (Sec 24-T14S-R3W) NE NE NE NE	5154.54	5344.99	38.82669	97.59432	RIM 1226.66 TOC 1226.31
MW-3 NW NW NW NW	5219.39	5113.02	38.82689	97.59351	RIM 1227.92 TOC 1227.53
MW-4 NW NW NW NW	5036.08	5139.09	38.82639	97.59361	RIM 1226.27 TOC 1225.99
MW-5 NE NW NW NW	5111.88	4941.74	38.82659	97.59293	RIM 1226.38 TOC 1226.01

