

WATER WELL RECORD Form WWC-5


Division of Water Resources App. No.

Well ID E-3R

Original Record Correction Change in Well Use

| | | | | |
|---|--|-----------------------------|----------------------------------|---|
| 1 LOCATION OF WATER WELL: County: <u>Saline</u> | Fraction <u>NE 1/4 SW 1/4 NE 1/4 NW 1/4</u> | Section Number <u>16</u> | Township Number <u>T 14 S</u> | Range Number <u>R 2</u> <input type="checkbox"/> E <input checked="" type="checkbox"/> W |
|---|--|-----------------------------|----------------------------------|---|

2 WELL OWNER: Last Name: Exline Leasing, Inc. First: _____
 Business: Exline Leasing, Inc. Street or Rural Address where well is located (if unknown, distance and direction from nearest town or intersection): If at owner's address, check here:
 Address: 3256 E. Country Club Road
 Address: _____
 City: Salina State: KS ZIP: 67401

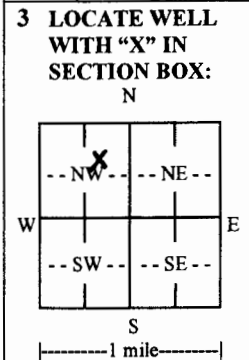

4 DEPTH OF COMPLETED WELL: 55.5 ft.
 Depth(s) Groundwater Encountered: 1) _____ ft.
 2) _____ ft. 3) _____ ft., or 4) Dry Well
 WELL'S STATIC WATER LEVEL: 27.45 ft.
 below land surface, measured on (mo-day-yr) 9/3/2016
 above land surface, measured on (mo-day-yr) _____
 Pump test data: Well water was _____ ft.
 after _____ hours pumping _____ gpm
 Well water was _____ ft.
 after _____ hours pumping _____ gpm
 Estimated Yield: _____ gpm
 Bore Hole Diameter: 12 in. to 57 ft. and _____ in. to _____ ft.

5 Latitude: 38.839190 (decimal degrees)
Longitude: -97.551461 (decimal degrees)
 Horizontal Datum: WGS 84 NAD 83 NAD 27
 Source for Latitude/Longitude:
 GPS (unit make/model: _____) (WAAS enabled? Yes No)
 Land Survey Topographic Map
 Online Mapper: Google Earth

6 Elevation: ~1227 ft. Ground Level TOC
 Source: Land Survey GPS Topographic Map
 Other Google Earth

7 WELL WATER TO BE USED AS:

| | | |
|--|---|---|
| 1. Domestic: <input type="checkbox"/> Household <input type="checkbox"/> Lawn & Garden <input type="checkbox"/> Livestock | 5. <input type="checkbox"/> Public Water Supply: well ID _____ 6. <input type="checkbox"/> Dewatering: how many wells? _____ 7. <input type="checkbox"/> Aquifer Recharge: well ID _____ 8. <input type="checkbox"/> Monitoring: well ID _____ | 10. <input type="checkbox"/> Oil Field Water Supply: lease _____ 11. Test Hole: well ID _____ <input type="checkbox"/> Cased <input type="checkbox"/> Uncased <input type="checkbox"/> Geotechnical |
| 2. <input type="checkbox"/> Irrigation | 9. Environmental Remediation: well ID <u>E-3R</u> <input type="checkbox"/> Air Sparge <input type="checkbox"/> Soil Vapor Extraction <input checked="" type="checkbox"/> Recovery <input type="checkbox"/> Injection | 12. Geothermal: how many bores? _____ a) Closed Loop <input type="checkbox"/> Horizontal <input type="checkbox"/> Vertical b) Open Loop <input type="checkbox"/> Surface Discharge <input type="checkbox"/> Inj. of Water |
| 3. <input type="checkbox"/> Feedlot | 4. <input type="checkbox"/> Industrial | 13. <input type="checkbox"/> Other (specify): _____ |

Was a chemical/bacteriological sample submitted to KDHE? Yes No If yes, date sample was submitted: _____
 Water well disinfected? Yes No

8 TYPE OF CASING USED: Steel PVC Other _____ CASING JOINTS: Glued Clamped Welded Threaded
 Casing diameter 5 in. to 40.5 ft., Diameter _____ in. to _____ ft., Diameter _____ in. to _____ ft.
 Casing height above land surface 12 in. Weight _____ lbs./ft. Wall thickness or gauge No. Sch. 40

TYPE OF SCREEN OR PERFORATION MATERIAL:
 Steel Stainless Steel Fiberglass PVC Other (Specify) _____
 Brass Galvanized Steel Concrete tile None used (open hole)

SCREEN OR PERFORATION OPENINGS ARE:
 Continuous Slot Mill Slot Gauze Wrapped Torch Cut Drilled Holes Other (Specify) _____
 Louvered Shutter Key Punched Wire Wrapped Saw Cut None (Open Hole)

SCREEN-PERFORATED INTERVALS: From 40.5 ft. to 55.5 ft., From _____ ft. to _____ ft., From _____ ft. to _____ ft.
 GRAVEL PACK INTERVALS: From 36 ft. to 55.5 ft., From _____ ft. to _____ ft., From _____ ft. to _____ ft.

9 GROUT MATERIAL: Neat cement Cement grout Bentonite Other _____
 Grout Intervals: From 4 ft. to 36 ft., From _____ ft. to _____ ft., From _____ ft. to _____ ft.

Nearest source of possible contamination:
 Septic Tank Lateral Lines Pit Privy Livestock Pens Insecticide Storage
 Sewer Lines Cess Pool Sewage Lagoon Fuel Storage Abandoned Water Well
 Watertight Sewer Lines Seepage Pit Feedyard Fertilizer Storage Oil Well/Gas Well
 Other (Specify) Industrial facility
 Direction from well? _____ Distance from well? _____ ft.

| 10 FROM | TO | LITHOLOGIC LOG | FROM | TO | LITHO. LOG (cont.) or PLUGGING INTERVALS |
|---------|------|---|--------|----|--|
| 0 | 8 | Clay, silty, Brown | 54 | 55 | Clay (wthrd shale), Gray |
| 8 | 15 | Sand, f, Orange | 55 | 57 | Shale, Gray |
| 15 | 17 | Clay | | | |
| 17 | 20.2 | Sand, f, Tan and Brown | | | |
| 20.2 | 25.3 | Silt, clayey, sandy (vf), Tan | | | |
| 25.3 | 28 | Sand, vf-f, Brown | | | |
| 28 | 35.3 | Clay, v. stiff, Gray and Red | Notes: | | |
| 35.3 | 40 | Sand, f-m, clayey, Orange Brown | | | |
| 40 | 54 | Sand and gravel, f-m, w/thin clay lense | | | |

11 CONTRACTOR'S OR LANDOWNER'S CERTIFICATION: This water well was constructed, reconstructed, or plugged under my jurisdiction and was completed on (mo-day-year) 9/2/2016 and this record is true to the best of my knowledge and belief. Kansas Water Well Contractor's License No. 527. This Water Well Record was completed on (mo-day-year) 9/8/2016 under the business name of GeoCore Inc. Signature: Dan A. [Signature]



Google earth



Exline Leasing, Inc.
3256 E. Country Club Road
Salina, Kansas

GPS Coordinates:

West well (E-3R): 38.839190, -97.551461

East well (B-7R): 38.839016, -97.551150