


1 LOCATION-OF WATER WELL: County: <u>SALINE</u>	Fraction <u>SE 1/4 SW 1/4 SW 1/4</u>	Section Number <u>30</u>	Township Number <u>T 17S</u>	Range Number <u>R 2E</u>
--	---	-----------------------------	---------------------------------	-----------------------------

Distance and direction from nearest town or city street address of well if located within city?

2323 Shalimar

2 WATER WELL OWNER: RR#, St. Address, Box # : City, State, ZIP Code	<u>DICK McCLANATHAN</u> <u>2323 Shalimar</u> <u>SALINA KS 67401</u>	Board of Agriculture, Division of Water Resources Application Number:
---	---	--

3 LOCATE WELL'S LOCATION WITH AN "X" IN SECTION BOX:	4 DEPTH OF COMPLETED WELL <u>48 1/2</u> ft. ELEVATION: <u>123.1</u>
--	---

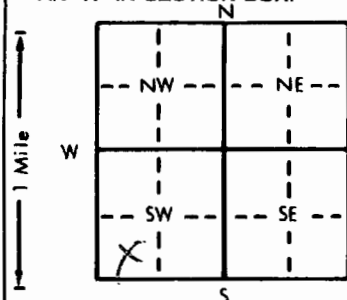

Depth(s) Groundwater Encountered	1. ft.	2. ft.	3. ft.
WELL'S STATIC WATER LEVEL	<u>14</u> ft. below land surface measured on mo/day/yr	<u>9-13-98</u>	
Pump test data: Well water was	<u>14</u> ft. after	<u>1</u> hours pumping	<u>15</u> gpm
Est. Yield	<u>40</u> gpm: Well water was	ft. after	hours pumping
Bore Hole Diameter	in. to	ft. and	in. to
WELL WATER TO BE USED AS:	5 Public water supply	8 Air conditioning	11 Injection well
1 Domestic	3 Feedlot	6 Oil field water supply	9 Dewatering
2 Irrigation	4 Industrial	<u>7</u> Lawn and garden only	10 Monitoring well
Was a chemical/bacteriological sample submitted to Department?	Yes	No	X
Water Well Disinfected?	Yes	X	No

5 TYPE OF BLANK CASING USED:	5 Wrought iron	8 Concrete tile	CASING JOINTS: Glued X	Clamped
1 Steel	3 RMP (SR)	6 Asbestos-Cement	9 Other (specify below)	Welded
<u>2</u> PVC	4 ABS	7 Fiberglass		Threaded
Blank casing diameter	<u>5</u> in. to <u>38 1/2</u> ft.	Dia	in. to	ft.
Casing height above land surface	<u>15</u> in. weight	<u>160 LB</u> lbs./ft.	Wall thickness or gauge No.	<u>3DR 26</u>

TYPE OF SCREEN OR PERFORATION MATERIAL:	1 Steel	3 Stainless steel	5 Fiberglass	8 RMP (SR)	10 Asbestos-cement
2 Brass	4 Galvanized steel	6 Concrete tile	9 ABS	11 Other (specify)	12 None used (open hole)

SCREEN OR PERFORATION OPENINGS ARE:	5 Gauzed wrapped	<u>8</u> Saw cut	11 None (open hole)
1 Continuous slot	3 Mill slot	6 Wire wrapped	9 Drilled holes
2 Louvered shutter	4 Key punched	7 Torch cut	10 Other (specify)

SCREEN-PERFORATED INTERVALS:	From <u>38 1/2</u> ft. to <u>48 1/2</u> ft.	From	ft. to	ft.
GRAVEL PACK INTERVALS:	From <u>14</u> ft. to <u>48 1/2</u> ft.	From	ft. to	ft.

6 GROUT MATERIAL:	<u>1</u> Neat cement	2 Cement grout	3 Bentonite	4 Other
Grout Intervals:	From <u>0</u> ft. to <u>14</u> ft.	From	ft. to	ft.

What is the nearest source of possible contamination:	10 Livestock pens	14 Abandoned water well	
1 Septic tank	4 Lateral lines	7 Pit privy	
2 Sewer lines	5 Cess pool	8 Sewage lagoon	
<u>3</u> Watertight sewer lines	6 Seepage pit	9 Feedyard	
Direction from well?	<u>EAST + NORTH</u>	How many feet?	<u>18 + 18</u>

FROM	TO	LITHOLOGIC LOG	FROM	TO	PLUGGING INTERVALS
0'	6'	Compacted dirt & silt			TALKED TO Don Taylor about depth of GROUT ON 8-17-98 KDHE
6'	10'	clay + SAND mixed			
10'	29'	fine + medium SAND			
29'	31'	clay + SAND, mixed			
31'	39'	medium SAND			
39'	40'	grey clay			
40'	48 1/2'	coarse SAND + Gravel			

7 CONTRACTOR'S OR LANDOWNER'S CERTIFICATION: This water well was	<u>(1)</u> constructed, (2) reconstructed, or (3) plugged under my jurisdiction and was
completed on (mo/day/year)	<u>8-16-98</u> and this record is true to the best of my knowledge and belief. Kansas
Water Well Contractor's License No.	<u>523</u> This Water Well Record was completed on (mo/day/yr)
under the business name of	<u>MAD Well Service</u> by (signature) <u>Matthew Soukup</u>