


1 LOCATION OF WATER WELL: County: Saline Fraction: SE 1/4 SW 1/4 SW 1/4 Section Number: 30 Township Number: T 14 S Range Number: R 2 EW

Distance and direction from nearest town or city street address of well if located within city? 2319 Shalimar

2 WATER WELL OWNER: Dave Freeland
 RR#, St. Address, Box #: 2319 Shalimar
 City, State, ZIP Code: Salina, KS 67401
 Board of Agriculture, Division of Water Resources
 Application Number:

3 LOCATE WELL'S LOCATION WITH AN "X" IN SECTION BOX:

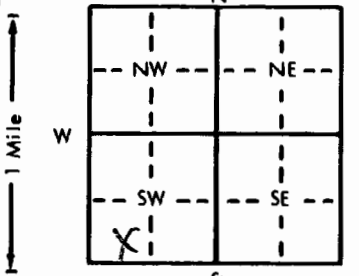

4 DEPTH OF COMPLETED WELL: 48 1/2 ft. ELEVATION: 123.1

Depth(s) Groundwater Encountered 1. 14 ft. 2. 14 ft. 3. 14 ft.
 WELL'S STATIC WATER LEVEL 14 ft. below land surface measured on mo/day/yr 8-8-98
 Pump test data: Well water was 14 ft. after 1 hours pumping 15 gpm
 Est. Yield 40 gpm: Well water was 14 ft. after 1 hours pumping 15 gpm
 Bore Hole Diameter: 8 1/2 in. to 15 in. and 15 in. to 15 in.
 WELL WATER TO BE USED AS:
 1 Domestic 3 Feedlot 5 Public water supply 8 Air conditioning 11 Injection well
 2 Irrigation 4 Industrial 6 Oil field water supply 9 Dewatering 12 Other (Specify below)
 7 Lawn and garden only 10 Monitoring well
 Was a chemical/bacteriological sample submitted to Department? Yes No X; If yes, mo/day/yr sample was submitted
 Water Well Disinfected? Yes X No

5 TYPE OF BLANK CASING USED:
 1 Steel 3 RMP (SR) 5 Wrought iron 8 Concrete tile CASING JOINTS: Glued X Clamped
 2 PVC 4 ABS 6 Asbestos-Cement 9 Other (specify below) Welded
 7 Fiberglass Threaded

Blank casing diameter 5 in. to 38 1/2 in. Dia. 160 LB. lbs./ft. Wall thickness or gauge No. SDR26
 Casing height above land surface 15 in., weight 160 LB.

TYPE OF SCREEN OR PERFORATION MATERIAL:
 1 Steel 3 Stainless steel 5 Fiberglass 7 PVC 10 Asbestos-cement
 2 Brass 4 Galvanized steel 6 Concrete tile 8 RMP (SR) 11 Other (specify)
 9 ABS 12 None used (open hole)

SCREEN OR PERFORATION OPENINGS ARE:
 1 Continuous slot 3 Mill slot 5 Gauzed wrapped 8 Saw cut 11 None (open hole)
 2 Louvered shutter 4 Key punched 6 Wire wrapped 9 Drilled holes
 7 Torch cut 10 Other (specify)

SCREEN-PERFORATED INTERVALS: From 38 1/2 ft. to 48 1/2 ft., From 14 ft. to 48 1/2 ft.
 GRAVEL PACK INTERVALS: From 14 ft. to 48 1/2 ft., From 14 ft. to 48 1/2 ft.

6 GROUT MATERIAL: 1 Neat cement 2 Cement grout 3 Bentonite 4 Other
 Grout Intervals: From 0 ft. to 14 ft., From 14 ft. to 48 1/2 ft.

What is the nearest source of possible contamination:
 1 Septic tank 4 Lateral lines 7 Pit privy 10 Livestock pens 14 Abandoned water well
 2 Sewer lines 5 Cess pool 8 Sewage lagoon 11 Fuel storage 15 Oil well/Gas well
 3 Watertight sewer lines 6 Seepage pit 9 Feedyard 12 Fertilizer storage 16 Other (specify below)
 13 Insecticide storage
 Direction from well? EAST & SOUTH How many feet? 22' x 15'

FROM	TO	LITHOLOGIC LOG	FROM	TO	PLUGGING INTERVALS
0	4'	Compacted dirt & silt			
4'	28'	fine to medium sand			CONTACTED DON T. AT KDHE ON 8-7-98
28'	30'	Brown clay & SAND mixed			12:30 PM about 90 FT depth
30'	34'	Coarse SAND & gravel			
34'	37'	Grey clay & SAND			
37'	48 1/2'	coarse gravel & SAND			

7 CONTRACTOR'S OR LANDOWNER'S CERTIFICATION: This water well was (1) constructed, (2) reconstructed, or (3) plugged under my jurisdiction and was completed on (mo/day/year) 8-9-98 and this record is true to the best of my knowledge and belief. Kansas Water Well Contractor's License No. 523 This Water Well Record was completed on (mo/day/yr) 8-12-98 under the business name of M&D Well Service by (signature) Matthew Janney