


1 LOCATION OF WATER WELL: Fraction **SW 1/4 NE 1/4 SE 1/4** Section Number **9** Township Number **T 14 S** Range Number **R 2 E/W**
 County: **Saline**

Distance and direction from nearest town or city street address of well if located within city?
1700 East Iron, Salina, Kansas

2 WATER WELL OWNER: **Scoular Elevator**
 RR#, St. Address, Box # : **1700 East Iron** Board of Agriculture, Division of Water Resources
 City, State, ZIP Code : **Salina, Ks.** Application Number:

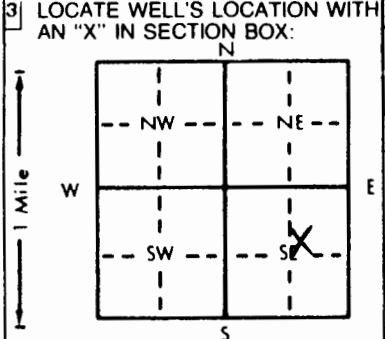

4 DEPTH OF COMPLETED WELL: **52** ft. ELEVATION: **NA**
 Depth(s) Groundwater Encountered 1. **12** ft. 2. ft. 3. ft.
 WELL'S STATIC WATER LEVEL: **12** ft. below land surface measured on mo/day/yr **01-02-94**
 Pump test data: Well water was ft. after hours pumping gpm
 Est. Yield gpm: Well water was ft. after hours pumping gpm
 Bore Hole Diameter: **8** in. to **59** ft., and in. to ft.
 WELL WATER TO BE USED AS:
 5 Public water supply 8 Air conditioning 11 Injection well
 1 Domestic 3 Feedlot 6 Oil field water supply 9 Dewatering 12 Other (Specify below)
 2 Irrigation 4 Industrial 7 Lawn and garden only **10** Monitoring well
 Was a chemical/bacteriological sample submitted to Department? Yes No **X**; If yes, mo/day/yr sample was submitted
 Water Well Disinfected? Yes No **X**

5 TYPE OF BLANK CASING USED:
 1 Steel 3 RMP (SR) 5 Wrought iron 8 Concrete tile CASING JOINTS: Glued Clamped
2 PVC 4 ABS 6 Asbestos-Cement 9 Other (specify below) Welded
 7 Fiberglass Threaded **X**
 Blank casing diameter **2** in. to **17** ft., Dia in. to ft., Dia in. to ft.
 Casing height above land surface **24** in., weight lbs./ft. Wall thickness or gauge **sch 40**
 TYPE OF SCREEN OR PERFORATION MATERIAL:
 1 Steel 3 Stainless steel 5 Fiberglass 8 RMP (SR) 10 Asbestos-cement
 2 Brass 4 Galvanized steel 6 Concrete tile 9 ABS 11 Other (specify)
 12 None used (open hole)
 SCREEN OR PERFORATION OPENINGS ARE:
 1 Continuous slot **3** Mill slot .010 5 Gauzed wrapped 8 Saw cut 11 None (open hole)
 2 Louvered shutter 4 Key punched 6 Wire wrapped 9 Drilled holes
 7 Torch cut 10 Other (specify)
 SCREEN-PERFORATED INTERVALS: From **52** ft. to **17** ft., From ft. to ft.
 From ft. to ft., From ft. to ft.
 GRAVEL PACK INTERVALS: From **59** ft. to **15** ft., From ft. to ft.
 From ft. to ft., From ft. to ft.

6 GROUT MATERIAL: 1 Neat cement **2** Cement grout **3** Bentonite 4 Other
 Grout Intervals: From **15** ft. to **4 (b)** ft., From **4** ft. to **0 (c)** ft., From ft. to ft.
 What is the nearest source of possible contamination:
 1 Septic tank 4 Lateral lines 7 Pit privy 10 Livestock pens 14 Abandoned water well
 2 Sewer lines 5 Cess pool 8 Sewage lagoon 11 Fuel storage 15 Oil well/Gas well
 3 Watertight sewer lines 6 Seepage pit 9 Feedyard 12 Fertilizer storage **16** Other (specify below)
 unknown
 Direction from well? **unknown** How many feet? **unknown**

FROM	TO	LITHOLOGIC LOG	FROM	TO	PLUGGING INTERVALS
0	1	clay, dark gray, organic			
1	11	clay, dark gray			
11	12	clay, tan, silty			
12	16	clay, brown, plastic, dry			
16	19	sand, tan, fine grained, clayey, w/thin sandy clay layers, wet			
19	21	sand and gravel, slightly clayey, tan			
21	27	clay, dark gray, silty to sandy			
27	31	clay, dark gray			
31	36.5	sand and gravel, clayey			
36.5	39	sand and gravel, ironstone grains			
39	43	clay, sandy			
43	46	sand and gravel, clayey			
46	52	sand and gravel, ironstone grains			
52	59	clay, gray, hard, with traces of light gray shale			MW8-above ground cover

7 CONTRACTOR'S OR LANDOWNER'S CERTIFICATION: This water well was **(1)** constructed, (2) reconstructed, or (3) plugged under my jurisdiction and was completed on (mo/day/year) **01-12-94** and this record is true to the best of my knowledge and belief. Kansas Water Well Contractor's License No. **527** This Water Well Record was completed on (mo/day/yr) **01-18-94** under the business name of **GeoCore Services, Inc.** by (signature) *Dale Bell*

INSTRUCTIONS: Use typewriter or ball point pen. PLEASE PRESS FIRMLY and PRINT clearly. Please fill in blanks, underline or circle the correct answers. Send top three copies to Kansas Department of Health and Environment, Bureau of Water, Topeka, Kansas 66620-0001. Telephone: 913-296-5545. Send one to WATER WELL OWNER and retain one for your records.