


1 LOCATION OF WATER WELL: County: SALINE Fraction NW NE SE Section Number 9 Township Number T 14 S Range Number R 2 EW

Distance and direction from nearest town or city street address of well if located within city?
425 N. SIMPSON RD.

2 WATER WELL OWNER: GREGORY MORGAN
RR#, St. Address, Box # : 425 N. SIMPSON RD. Board of Agriculture, Division of Water Resources
City, State, ZIP Code : SALINA, KS. 67401 Application Number:

3 LOCATE WELL'S LOCATION WITH AN "X" IN SECTION BOX:

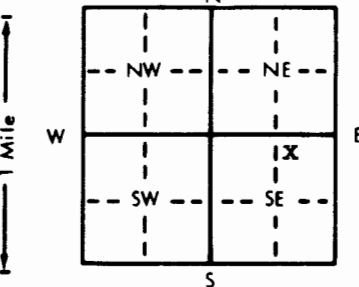

4 DEPTH OF COMPLETED WELL: 51 ft. ELEVATION: 1217
Depth(s) Groundwater Encountered 1. 23 ft. 2. . ft. 3. . ft.
WELL'S STATIC WATER LEVEL 23 ft. below land surface measured on mo/day/yr 6-10-89
Pump test data: Well water was 40 ft. after 1 hours pumping 25 gpm
Est. Yield 25 gpm: Well water was . ft. after . hours pumping . gpm
Bore Hole Diameter 9 in. to 51 ft., and . in. to . ft.
WELL WATER TO BE USED AS:
1 Domestic 3 Feedlot 6 Oil field water supply 9 Dewatering 12 Other (Specify below)
2 Irrigation 4 Industrial 7 Lawn and garden only 10 Monitoring well
Was a chemical/bacteriological sample submitted to Department? Yes. . No X .; If yes, mo/day/yr sample was submitted
Water Well Disinfected? Yes X No

5 TYPE OF BLANK CASING USED:
1 Steel 3 RMP (SR) 5 Wrought iron 8 Concrete tile CASING JOINTS: Glued X Clamped .
2 PVC 4 ABS 6 Asbestos-Cement 9 Other (specify below) Welded .
7 Fiberglass . Threaded .

Blank casing diameter 5 in. to 41 ft., Dia . in. to . ft., Dia . in. to . ft.
Casing height above land surface 12 in., weight 160 lbs./ft. Wall thickness or gauge No. SDR 26

TYPE OF SCREEN OR PERFORATION MATERIAL:
1 Steel 3 Stainless steel 5 Fiberglass 7 PVC 10 Asbestos-cement
2 Brass 4 Galvanized steel 6 Concrete tile 8 RMP (SR) 11 Other (specify) .
12 None used (open hole)

SCREEN OR PERFORATION OPENINGS ARE:
1 Continuous slot 3 Mill slot 5 Gauzed wrapped 8 Saw cut 11 None (open hole)
2 Louvered shutter 4 Key punched 6 Wire wrapped 9 Drilled holes
7 Torch cut 10 Other (specify) .

SCREEN-PERFORATED INTERVALS: From 41 ft. to 51 ft., From . ft. to . ft.
From . ft. to . ft., From . ft. to . ft.
GRAVEL PACK INTERVALS: From 35 ft. to 51 ft., From . ft. to . ft.
From . ft. to . ft., From . ft. to . ft.

6 GROUT MATERIAL: 1 Neat cement 2 Cement grout 3 Bentonite 4 Other .
Grout Intervals: From 6 ft. to 30 ft., From . ft. to . ft., From . ft. to . ft.

What is the nearest source of possible contamination:
1 Septic tank 4 Lateral lines 7 Pit privy 10 Livestock pens 14 Abandoned water well
2 Sewer lines 5 Cess pool 8 Sewage lagoon 11 Fuel storage 15 Oil well/Gas well
3 Watertight sewer lines 6 Seepage pit 9 Feedyard 12 Fertilizer storage 16 Other (specify below)
13 Insecticide storage .

Direction from well? WEST How many feet? 75

FROM	TO	LITHOLOGIC LOG	FROM	TO	PLUGGING INTERVALS
0	3	TOP SOIL			
3	41	CLAY			
41	51	MED. SAND			

7 CONTRACTOR'S OR LANDOWNER'S CERTIFICATION: This water well was (1) constructed, (2) reconstructed, or (3) plugged under my jurisdiction and was completed on (mo/day/year) 6-10-89 and this record is true to the best of my knowledge and belief. Kansas Water Well Contractor's License No. 388 This Water Well Record was completed on (mo/day/yr) 6-10-89 under the business name of PESTINGER PUMP SERVICE by (signature) [Signature]