USE TYPEWRITER OR BALL POINT PEN-PRESS FIRMLY, PRINT CLEARLY.

WATER WELL RECORD
KSA 82a-1201-1215

Kansas Department of Health and Environment-Division of Environment
(Water well Contractors)
Topeka, Kansas 66620

1. Location of well:	County	Fraction	Section number	Township number	Range number
	Saline	SW 1/4 SW 1/4 NE 1/4	15	T 14 S	R 2 E/W

2. Distance and direction from nearest town or city: 2½ miles east of Salina
Street address of well location if in city:

3. Owner of well: Dan King
R.R. or street: 420 N. Broadway
City, state, zip code: Salina, Kansas 67401

4. Locate with "X" in section below:

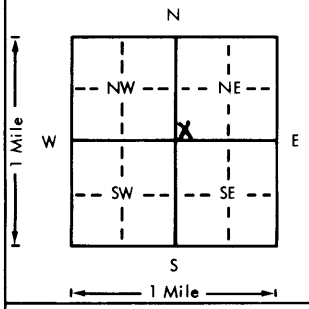

Sketch map: Well was drilled in a field

6. Bore hole dia. 8 in. Completion date
Well depth 26 ft. 6 - 6 - 77

7. X Cable tool __ Rotary __ Driven __ Dug
__ Hollow rod __ Jetted __ Bored __ Reverse rotary

8. Use: X Domestic __ Public supply __ Industry
__ Irrigation __ Air conditioning __ Stock
__ Lawn __ Oil field water __ Other

9. Casing: Material plst Height: Above or ~~Below~~
Threaded __ Welded gl Surface 18 in.
RMP X PVC __ Weight __ lbs./ft.
Dia. 5 in. to 26 ft. depth Wall Thickness: inches or
Dia. __ in. to __ ft. depth gage No. 0.258

5. Type and color of material	From	To
Top soil	0	4
Light brown clay	4	7
Clay and gravel	7	11
Gravel	11	14
Red clay	14	19
Blue and gypsum rock	19	26
(Use a second sheet if needed)		

10. Screen: Manufacturer's name Western Plastics
Type RMP Dia. 5"
Slot/gauze 3/32 Length 19'
Set between 7 ft. and 26 ft.
__ ft. and __ ft.
Gravel pack? Yes Size range of material 1/16 to 3/8

11. Static water level: mo./day/yr.
15 ft. below land surface Date 6/6/77

12. Pumping level below land surfaces:
__ ft. after __ hrs. pumping __ g.p.m.
__ ft. after __ hrs. pumping __ g.p.m.
Estimated maximum yield 16+ g.p.m.

13. Water sample submitted: mo./day/yr.
__ Yes X No Date

14. Well head completion:
__ Pitless adapter 18 Inches above grade

15. Well grouted? Yes
With: X Neat cement __ Bentonite __ Concrete
Depth: From 0 ft. to 10 ft.

16. Nearest source of possible contamination:
ft. __ Direction __ Type none
Well disinfected upon completion? X Yes __ No

17. Pump: X Not installed
Manufacturer's name
Model number HP Volts
Length of drop pipe ft. capacity g.p.m.
Type:
__ Submersible __ Turbine
__ Jet __ Reciprocating
__ Centrifugal __ Other

18. Elevation:
Topography:
__ Hill
__ Slope
__ Upland
__ Valley

19. Remarks:

20. Water well contractor's certification:
This well was drilled under my jurisdiction and this report is true to the best of my knowledge and belief.
Business name Rader Drilling Co. License No. 194
Address Carlton, Kansas 67429
Signed Brent C Rader Date 8-15-77
Authorized representative

T 14 R 2 E/W Sec 15 1/4 SW 1/4 SW 1/4 NE 1/4

Forward the white, blue and pink copies to the Department of Health and Environment

Form WWC-5

M1-1023