USE TYPEWRITER OR BALL POINT PEN-PRESS FIRMLY, PRINT CLEARLY.

**WATER WELL RECORD**
KSA 82a-1201-1215

Kansas Department of Health and Environment-Division of Environment
(Water well Contractors)
Topeka, Kansas 66620

| 1. Location of well: | County | Fraction | Section number | Township number | Range number |
|---|---|---|---|---|---|
| | Saline | NW 1/4 NE 1/4 NW 1/4 | 16 | T 14 S | R 2 W E/W |

2. Distance and direction from nearest town or city:
Street address of well location if in city: 1 E. SALINA

3. Owner of well: Jim Gibbs
R.R. or street: Rt. 5
City, state, zip code: Salina Kans 67401

4. Locate with "X" in section below:

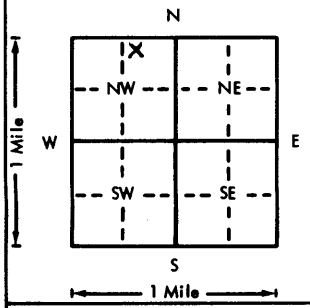


Sketch map:

6. Bore hole dia. 6 in. Completion date 2-2-76
Well depth 34.5 ft.

7. __ Cable tool X Rotary __ Driven __ Dug
__ Hollow rod __ Jetted __ Bored __ Reverse rotary

8. Use: X Domestic __ Public supply __ Industry
__ Irrigation __ Air conditioning __ Stock
__ Lawn __ Oil field water __ Other

9. Casing: Material PVC Height: (Above) or below
Threaded ___ Welded ___ Surface 12 in.
RMP ___ PVC ___ Weight ___ lbs./ft.
Dia. 4 in. to 34.5 ft. depth Wall Thickness: inches or
Dia. ___ in. to ___ ft. depth gage No. 1237

| 5. Type and color of material | From | To |
|---|---|---|
| in feet below surface | | |
| Jeanne deposits: | | |
| Clay silty, gray to tan | 0 | 28 |
| Gravel, fine to medium & sand fine (K-derived) | 28 | 34.5 |
| Wellington: | | |
| Shale, yellow | 34.5 | 35 |
| | | |
| | | |
| | | |
| | | |
| | | |
| | | |
| | | |
| | | |
| | | |
| | | |
| | | |
| (Use a second sheet if needed) | | |

10. Screen: Manufacturer's name Shop
Type PVC Dia. 4"
Slot/gauze ~~3/5~~ 1/16 Length 2.5'
Set between 32 ft. and 34.5 ft.
___ ft. and ___ ft.
Gravel pack? Y Size range of material 1/10"

11. Static water level: mo./day/yr.
22 ft. below land surface Date 2-2-76

12. Pumping level below land surfaces:
29 ft. after 1/2 hrs. pumping 4 g.p.m.
___ ft. after ___ hrs. pumping ___ g.p.m.
Estimated maximum yield 8 g.p.m.

13. Water sample submitted: mo./day/yr.
__ Yes X No Date

14. Well head completion:
__ Pitless adapter 12 Inches above grade

15. Well grouted? Y
With: X Neat cement __ Bentonite __ Concrete
Depth: From 3 ft. to 13 ft.

16. Nearest source of possible contamination:
ft. ___ Direction ___ Type ___
Well disinfected upon completion? Y Yes __ No

17. Pump: X Not installed
Manufacturer's name ___
Model number ___ HP ___ Volts ___
Length of drop pipe ___ ft. capacity ___ g.p.m.
Type:
__ Submersible __ Turbine
__ Jet __ Reciprocating
__ Centrifugal __ Other

18. Elevation:

Topography:
__ Hill
X Slope
__ Upland
__ Valley

19. Remarks:

20. Water well contractor's certification:
This well was drilled under my jurisdiction and this report is true to the best of my knowledge and belief.
Hydraulic Drilling 126
Business name License No.
Address Rt 2 Salina Ks
Signed Ol Ford Date 3-1-76
Authorized representative

T 14 R 2 W Sec 16 1/4 NW 1/4 NW 1/4

Forward the white, blue and pink copies to the Department of Health and Environment

Form WWC-5

MI-1023