


1 LOCATION OF WATER WELL: County: Saline Fraction: SE 1/4 SW 1/4 SW 1/4 Section Number: 30 Township Number: T 14 Range Number: R 2 E/W

Distance and direction from nearest town or city street address of well if located within city? 1/4 mi. East of Salina

2 WATER WELL OWNER: Dale Reese RR#, St. Address, Box #: 602 Straight Drive City, State, ZIP Code: Salina, Ks. 67401 Board of Agriculture, Division of Water Resources Application Number:

3 LOCATE WELL'S LOCATION WITH AN "X" IN SECTION BOX:

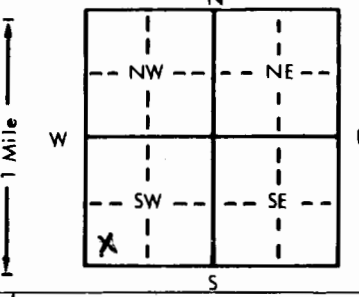

4 DEPTH OF COMPLETED WELL: 41 ft. ELEVATION: ... ft. Depth(s) Groundwater Encountered: 1. 17 ft. 2. ... ft. 3. ... ft. WELL'S STATIC WATER LEVEL: 17 ft. below land surface measured on mo/day/yr 9-13-83 Pump test data: Well water was ... ft. after ... hours pumping ... gpm Est. Yield: 50 gpm: Well water was ... ft. after ... hours pumping ... gpm Bore Hole Diameter: 8 in. to 4 1/2 in. to ... in. to ... ft. WELL WATER TO BE USED AS: 5 Public water supply 8 Air conditioning 11 Injection well 1 Domestic 3 Feedlot 6 Oil field water supply 9 Dewatering 12 Other (Specify below) 2 Irrigation 4 Industrial 7 Lawn and garden only 10 Observation well Was a chemical/bacteriological sample submitted to Department? Yes... No If yes, mo/day/yr sample was submitted Water Well Disinfected? Yes No

5 TYPE OF BLANK CASING USED: 1 Steel 3 RMP (SR) 5 Wrought iron 8 Concrete tile CASING JOINTS: Glued Clamped ... 2 PVC 4 ABS 7 Fiberglass ... Welded ... Threaded ...

Blank casing diameter: 5 in. to 3 1/2 in. Dia. in. to ... in. Dia. in. to ... in. Casing height above land surface: 12 in., weight: 2.91 lbs./ft. Wall thickness or gauge No. 265

TYPE OF SCREEN OR PERFORATION MATERIAL: 1 Steel 3 Stainless steel 5 Fiberglass 7 PVC 10 Asbestos-cement 2 Brass 4 Galvanized steel 6 Concrete tile 8 RMP (SR) 11 Other (specify) ... 12 None used (open hole)

SCREEN OR PERFORATION OPENINGS ARE: 1 Continuous slot 3 Mill slot 5 Gauzed wrapped 8 Saw cut 11 None (open hole) 2 Louvered shutter 4 Key punched 6 Wire wrapped 9 Drilled holes 7 Torch cut 10 Other (specify) ...

SCREEN-PERFORATED INTERVALS: From 31 ft. to 41 ft., From ... ft. to ... ft. GRAVEL PACK INTERVALS: From 15 ft. to 41 ft., From ... ft. to ... ft.

6 GROUT MATERIAL: 1 Neat cement 2 Cement grout 3 Bentonite 4 Other Grout Intervals: From 5 ft. to 15 ft., From ... ft. to ... ft.

What is the nearest source of possible contamination: 1 Septic tank 4 Lateral lines 7 Pit privy 10 Livestock pens 14 Abandoned water well 2 Sewer lines 5 Cess pool 8 Sewage lagoon 11 Fuel storage 15 Oil well/Gas well 3 Watertight sewer lines 6 Seepage pit 9 Feedyard 12 Fertilizer storage 16 Other (specify below) 13 Insecticide storage Direction from well? NORTH How many feet? 150 ft

FROM	TO	LITHOLOGIC LOG	FROM	TO	LITHOLOGIC LOG
0	5	Top Soil			
5	14	01 Gray Clay			
14	20	04 Gray Clay & Fine Sand			
20	30	08 Medium Gray Sand			
30	41	09 Coarse Gray Sand			

7 CONTRACTOR'S OR LANDOWNER'S CERTIFICATION: This water well was (1) constructed, (2) reconstructed, or (3) plugged under my jurisdiction and was completed on (mo/day/year) 9-13-83 and this record is true to the best of my knowledge and belief. Kansas Water Well Contractor's License No. 136 This Water Well Record was completed on (mo/day/yr) 9-15-83 under the business name of Peterson Irrigation by (signature) Mike Peterson

INSTRUCTIONS: Use typewriter or ball point pen, PLEASE PRESS FIRMLY and PRINT clearly. Please fill in blanks, underline or circle the correct answers. Send top three copies to Kansas Department of Health and Environment, Division of Environment, Environmental Geology Section, Topeka, KS 66620. Send one to WATER WELL OWNER and retain one for your records.

OFFICE USE ONLY T 14 R 2 SEC. 30 SE 1/4 SW 1/4 SW 1/4

D