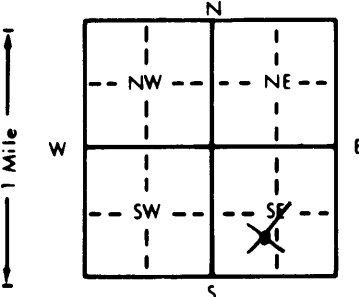


1 LOCATION OF WATER WELL: Fraction SE 1/4 SW 1/4 SE 1/4 Section Number 17 Township Number T 14 S Range Number R 2 E/W  
 County: Saline

Distance and direction from nearest town or city street address of well if located within city?  
In City Limits-2303 Georgetown

2 WATER WELL OWNER: Mike Chaput Board of Agriculture, Division of Water Resources  
 RR#, St. Address, Box # : 2303 Georgetown Application Number:  
 City, State, ZIP Code : Salina, KS 67401

3 LOCATE WELL'S LOCATION WITH AN "X" IN SECTION BOX:  4 DEPTH OF COMPLETED WELL: 62 ft. ELEVATION: .....  
 Depth(s) Groundwater Encountered 1. 22 ft. 2. .... ft. 3. .... ft.  
 WELL'S STATIC WATER LEVEL ... 22 ft. below land surface measured on mo/day/yr 11-11-94  
 Pump test data: Well water was ..... ft. after ..... hours pumping ..... gpm  
 Est. Yield ... 20 gpm: Well water was ..... ft. after ..... hours pumping ..... gpm  
 Bore Hole Diameter: ... 8 in. to ... 62 ft., and ..... in. to ..... ft.  
 WELL WATER TO BE USED AS: 5 Public water supply 8 Air conditioning 11 Injection well  
 1 Domestic 3 Feedlot 6 Oil field water supply 9 Dewatering 12 Other (Specify below)  
 2 Irrigation 4 Industrial 7 Lawn and garden only 10 Monitoring well  
 Was a chemical/bacteriological sample submitted to Department? Yes.....No.. X.....; If yes, mo/day/yr sample was submitted  
 Water Well Disinfected? Yes X No

5 TYPE OF BLANK CASING USED: 5 Wrought iron 8 Concrete tile CASING JOINTS: Glued .. X .. Clamped .....  
 1 Steel 3 RMP (SR) 6 Asbestos-Cement 9 Other (specify below) Welded .....  
 2 PVC 4 ABS 7 Fiberglass ..... Threaded .....  
 Blank casing diameter ..... 5 in. to ... 42 ft., Dia ..... in. to ..... ft., Dia ..... in. to ..... ft.  
 Casing height above land surface ..... 12 in., weight ..... 2.37 lbs./ft. Wall thickness or gauge No. ... 214  
 TYPE OF SCREEN OR PERFORATION MATERIAL: 7 PVC 10 Asbestos-cement  
 1 Steel 3 Stainless steel 5 Fiberglass 8 RMP (SR) 11 Other (specify) .....  
 2 Brass 4 Galvanized steel 6 Concrete tile 9 ABS 12 None used (open hole)  
 SCREEN OR PERFORATION OPENINGS ARE: 5 Gauzed wrapped 8 Saw cut 11 None (open hole)  
 1 Continuous slot 3 Mill slot 6 Wire wrapped 9 Drilled holes  
 2 Louvered shutter 4 Key punched 7 Torch cut 10 Other (specify) .....  
 SCREEN-PERFORATED INTERVALS: From ..... 42 ft. to ..... 62 ft., From ..... ft. to ..... ft.  
 From ..... ft. to ..... ft., From ..... ft. to ..... ft.  
 GRAVEL PACK INTERVALS: From ..... 25 ft. to ..... 62 ft., From ..... ft. to ..... ft.  
 From ..... ft. to ..... ft., From ..... ft. to ..... ft.

6 GROUT MATERIAL: 1 Neat cement 2 Cement grout 3 Bentonite 4 Other .....  
 Grout Intervals: From ..... 5 ft. to ..... 25 ft., From ..... ft. to ..... ft., From ..... ft. to ..... ft.  
 What is the nearest source of possible contamination:  
 1 Septic tank 4 Lateral lines 7 Pit privy 10 Livestock pens 14 Abandoned water well  
 2 Sewer lines 5 Cess pool 8 Sewage lagoon 11 Fuel storage 15 Oil well/Gas well  
 3 Watertight sewer lines 6 Seepage pit 9 Feedyard 12 Fertilizer storage 16 Other (specify below)  
 13 Insecticide storage  
 Direction from well? West How many feet? 50ft

FROM	TO	LITHOLOGIC LOG	FROM	TO	PLUGGING INTERVALS
0	2	Top Soil			
2	6	Gray Clay			
6	30	Tan Clay			
30	40	Tan Clay & Fine Sand Mixed			
40	50	Fine Sand			
50	56	Tan Clay			
56	62	Creek Gravel			
62		Green Shale			

7 CONTRACTOR'S OR LANDOWNER'S CERTIFICATION: This water well was (1) constructed, (2) reconstructed, or (3) plugged under my jurisdiction and was completed on (mo/day/year) ..... 11-11-94 ..... and this record is true to the best of my knowledge and belief. Kansas Water Well Contractor's License No. .... 138 ..... This Water Well Record was completed on (mo/day/yr) 11-23-94 under the business name of Peterson Irrigation Inc. by (signature) Mike Peterson

OFFICE USE ONLY  
T  
R  
EW  
SEC.  
1/4  
1/4  
1/4