


1 LOCATION OF WATER WELL: Fraction SW 1/4 NW 1/4 NW 1/4 Section Number 19 Township Number T 14 S Range Number R 2 EW  
 County: SALINE

Distance and direction from nearest town or city street address of well if located within city?  
 861 MANCHESTER RD

2 WATER WELL OWNER: PAUL FLYNN  
 RR#, St. Address, Box # : 861 MANCHESTER RD. Board of Agriculture, Division of Water Resources  
 City, State, ZIP Code : SALINA, KS. 67401 Application Number:

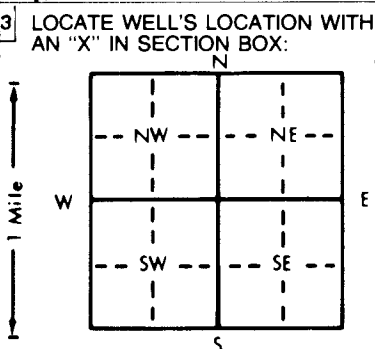

4 DEPTH OF COMPLETED WELL: 56.8 ft. ELEVATION: 1230  
 Depth(s) Groundwater Encountered 1. 24.8 ft. 2. ft. 3. ft.  
 WELL'S STATIC WATER LEVEL: 24.8 ft. below land surface measured on mo/day/yr 9-31-95  
 Pump test data: Well water was 25.8 ft. after 1 hours pumping 30 gpm  
 Est. Yield 7.5+ gpm: Well water was ft. after hours pumping gpm  
 Bore Hole Diameter: 9 in. to 57 ft., and in. to ft.  
 WELL WATER TO BE USED AS: 5 Public water supply 8 Air conditioning 11 Injection well  
 1 Domestic 3 Feedlot 6 Oil field water supply 9 Dewatering 12 Other (Specify below)  
 2 Irrigation 4 Industrial 7 Lawn and garden only 10 Monitoring well  
 Was a chemical/bacteriological sample submitted to Department? Yes No X If yes, mo/day/yr sample was submitted  
 Water Well Disinfected? Yes X No

5 TYPE OF BLANK CASING USED: 5 Wrought iron 8 Concrete tile CASING JOINTS: Glued X Clamped  
 1 Steel 3 RMP (SR) 6 Asbestos-Cement 9 Other (specify below) Welded  
 2 PVC 4 ABS 7 Fiberglass Threaded  
 Blank casing diameter 5 in. to 52 ft., Dia. in. to ft., Dia. in. to ft.  
 Casing height above land surface 18 in., weight 160 lbs./ft. Wall thickness or gauge No. SDR 26  
 TYPE OF SCREEN OR PERFORATION MATERIAL: 7 PVC 10 Asbestos-cement  
 1 Steel 3 Stainless steel 5 Fiberglass 8 RMP (SR) 11 Other (specify)  
 2 Brass 4 Galvanized steel 6 Concrete tile 9 ABS 12 None used (open hole)  
 SCREEN OR PERFORATION OPENINGS ARE: 5 Gauzed wrapped 8 Saw cut 11 None (open hole)  
 1 Continuous slot 3 Mill slot 0.035 6 Wire wrapped 9 Drilled holes  
 2 Louvered shutter 4 Key punched 7 Torch cut 10 Other (specify)  
 SCREEN-PERFORATED INTERVALS: From 52 ft. to 56.8 ft., From ft. to ft.  
 GRAVEL PACK INTERVALS: From 40 ft. to 56.8 ft., From ft. to ft.

6 GROUT MATERIAL: 1 Neat cement 2 Cement grout 3 Bentonite 4 Other  
 Grout intervals: From 0 ft. to 21 ft., From ft. to ft., From ft. to ft.  
 What is the nearest source of possible contamination:  
 1 Septic tank 4 Lateral lines 7 Pit privy 10 Livestock pens 14 Abandoned water well  
 2 Sewer lines 5 Cess pool 8 Sewage lagoon 11 Fuel storage 15 Oil well/Gas well  
 3 Watertight sewer lines 6 Seepage pit 9 Feedyard 12 Fertilizer storage 16 Other (specify below)  
 13 Insecticide storage  
 Direction from well? EAST How many feet? 25

FROM	TO	LITHOLOGIC LOG	FROM	TO	PLUGGING INTERVALS
0	3	TOP SOIL			
3	22	CLAY GRAY			
22	30	SANDY LOOM TAN			
30	41	SAND MED. TAN			
41	42	CLAY GRAY SOFT			
42	56.8	SAND MED. TO COARSE TAN			

7 CONTRACTOR'S OR LANDOWNER'S CERTIFICATION: This water well was (1) constructed, (2) reconstructed, or (3) plugged under my jurisdiction and was completed on (mo/day/year) 3-31-95 and this record is true to the best of my knowledge and belief. Kansas Water Well Contractor's License No. 388 This Water Well Record was completed on (mo/day/yr) 3-31-95 under the business name of PESTINGER PUMP SERVICE by (signature) Paul Flynn

OFFICE USE ONLY  
T  
R  
EW  
SEC.  
1/4  
1/4  
1/4