


1 LOCATION OF WATER WELL: Fraction WC 1/4 NE 1/4 SW 1/4 Section Number 3 Township Number T 14 S Range Number R 20 EW
 County: ELLIS

Distance and direction from nearest town or city street address of well if located within city?
4 South on blacktop off ELLIS Ks 1 East 1/2 South

2 WATER WELL OWNER: Karl Giedler
 RR#, St. Address, Box #: 725 N Washington Board of Agriculture, Division of Water Resources
 City, State, ZIP Code: ELLIS KS 67637 Application Number:

3 LOCATE WELL'S LOCATION WITH AN "X" IN SECTION BOX:

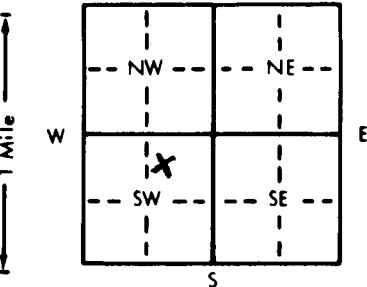

4 DEPTH OF COMPLETED WELL: 83 ft. ELEVATION:

Depth(s) Groundwater Encountered 1. 21 ft. 2. ft. 3. ft.
 WELL'S STATIC WATER LEVEL 16 ft. below land surface measured on mo/day/yr 5/2/84
 Pump test data: Well water was 65 ft. after 1 hours pumping gpm
 Est. Yield 10 gpm: Well water was ft. after hours pumping gpm
 Bore Hole Diameter 10 in. to ft., and in. to ft.
 WELL WATER TO BE USED AS:
 1 Domestic 2 Irrigation 3 Feedlot 4 Industrial
 5 Public water supply 6 Oil field water supply 7 Lawn and garden only
 8 Air conditioning 9 Dewatering 10 Observation well
 11 Injection well 12 Other (Specify below)
 Was a chemical/bacteriological sample submitted to Department? Yes No If yes, mo/day/yr sample was submitted
 Water Well Disinfected? Yes No

5 TYPE OF BLANK CASING USED:
 1 Steel 2 Brass 3 RMP (SR) 4 Galvanized steel
 2 PVC 4 ABS 5 Wrought iron 6 Asbestos-Cement 7 Fiberglass
 3 RMP (SR) 4 ABS 5 Wrought iron 6 Asbestos-Cement 7 Fiberglass
 8 Concrete tile 9 Other (specify below) 10 Asbestos-cement
 CASING JOINTS: Glued Clamped Welded Threaded

Blank casing diameter 5 in. to ft., Dia. in. to ft., Dia. in. to ft.
 Casing height above land surface 20 in., weight lbs./ft. Wall thickness or gauge No. SDR26

TYPE OF SCREEN OR PERFORATION MATERIAL:
 1 Steel 2 Brass 3 Stainless steel 4 Galvanized steel
 5 Fiberglass 6 Concrete tile 8 RMP (SR) 9 ABS 10 Asbestos-cement
 11 Other (specify) 12 None used (open hole)

SCREEN OR PERFORATION OPENINGS ARE:
 1 Continuous slot 2 Louvered shutter 3 Mill slot 4 Key punched
 5 Gauzed wrapped 6 Wire wrapped Saw cut 11 None (open hole)
 7 Torch cut 9 Drilled holes 10 Other (specify)

SCREEN-PERFORATED INTERVALS: From 23 ft. to 63 ft. From ft. to ft.
 From ft. to ft. From ft. to ft.
 GRAVEL PACK INTERVALS: From 16 ft. to 83 ft. From ft. to ft.
 From ft. to ft. From ft. to ft.

6 GROUT MATERIAL: 1 Neat cement 2 Cement grout 3 Bentonite 4 Other
 Grout Intervals: From 0 ft. to 15 ft. From ft. to ft. From ft. to ft.

What is the nearest source of possible contamination:
 1 Septic tank 2 Sewer lines 3 Watertight sewer lines 4 Lateral lines 5 Cess pool 6 Seepage pit
 7 Pit privy 8 Sewage lagoon 9 Feedyard 10 Livestock pens 14 Abandoned water well
 11 Fuel storage 12 Fertilizer storage 13 Insecticide storage 15 Oil well/Gas well 16 Other (specify below)
 Direction from well? South East How many feet? 25

FROM	TO	LITHOLOGIC LOG	FROM	TO	LITHOLOGIC LOG
0	2	Top soil			
2	21	Light white Rock			
21	82	Lime stone			
82	83	Shale			

7 CONTRACTOR'S OR LANDOWNER'S CERTIFICATION: This water well was (1) constructed, (2) reconstructed, or (3) plugged under my jurisdiction and was completed on (mo/day/year) 5/2/84 and this record is true to the best of my knowledge and belief. Kansas Water Well Contractor's License No. 276 This Water Well Record was completed on (mo/day/yr) 5/12/84 under the business name of LUSA Water Well by (signature) John Shea

INSTRUCTIONS: Use typewriter or ball point pen, PLEASE PRESS FIRMLY and PRINT clearly. Please fill in blanks, underline or circle the correct answers. Send top three copies to Kansas Department of Health and Environment, Division of Environment, Environmental Geology Section, Topeka, KS 66620. Send one to WATER WELL OWNER and retain one for your records.