


1 LOCATION OF WATER WELL: Fraction NE 1/4 SW 1/4 NW 1/4 Section Number 33 Township Number T 14 S Range Number R 21 EW
 County: Trego

Distance and direction from nearest town or city street address of well if located within city?
OGALLA 13 1/2 south on 147 3rd East

2 WATER WELL OWNER: Robert Schmidt
 RR#, St. Address, Box #: 2902 Country Lane Board of Agriculture, Division of Water Resources
 City, State, ZIP Code: HAYS KS 67667 Application Number:

3 LOCATE WELL'S LOCATION WITH AN "X" IN SECTION BOX:

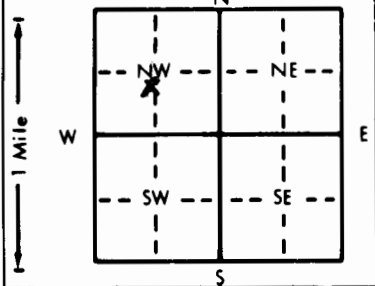

4 DEPTH OF COMPLETED WELL: 60 ft. ELEVATION: _____
 Depth(s) Groundwater Encountered 1. 10' ft. 2. _____ ft. 3. _____ ft.
 WELL'S STATIC WATER LEVEL 10 ft. below land surface measured on mo/day/yr
 Pump test data: Well water was 30 ft. after 2 hours pumping 365 gpm
 Est. Yield _____ gpm Well water was _____ ft. after _____ hours pumping _____ gpm
 Bore Hole Diameter: 1.6 in. to 6.0 ft., and _____ in. to _____ ft.
 WELL WATER TO BE USED AS:
 1 Domestic 3 Feedlot 6 Oil field water supply 9 Dewatering 12 Other (Specify below) _____
2 Irrigation 4 Industrial 7 Lawn and garden only 10 Monitoring well _____
 Was a chemical/bacteriological sample submitted to Department? Yes _____ No ; If yes, mo/day/yr sample was submitted _____
 Water Well Disinfected? Yes No _____

5 TYPE OF BLANK CASING USED:
 1 Steel 3 RMP (SR) 6 Asbestos-Cement 9 Other (specify below) _____
 2 PVC 4 ABS 7 Fiberglass _____
 Blank casing diameter 1.2 in. to 6.0 ft., Dia _____ in. to _____ ft., Dia _____ in. to _____ ft.
 Casing height above land surface 1.2 in., weight _____ lbs./ft. Wall thickness or gauge No. 1/4"
 TYPE OF SCREEN OR PERFORATION MATERIAL:
 1 Steel 3 Stainless steel 5 Fiberglass 8 RMP (SR) 11 Other (specify) _____
 2 Brass 4 Galvanized steel 6 Concrete tile 9 ABS 12 None used (open hole) _____
 SCREEN OR PERFORATION OPENINGS ARE:
 1 Continuous slot 3 Mill slot 5 Gauzed wrapped 8 Saw cut 11 None (open hole)
 2 Louvered shutter 4 Key punched 6 Wire wrapped 9 Drilled holes
 7 Torch cut 10 Other (specify) _____
 SCREEN-PERFORATED INTERVALS: From 60 ft. to 28 ft., From _____ ft. to _____ ft.
 From _____ ft. to _____ ft., From _____ ft. to _____ ft.
 GRAVEL PACK INTERVALS: From 60 ft. to 23 ft., From _____ ft. to _____ ft.
 From _____ ft. to _____ ft., From _____ ft. to _____ ft.

6 GROUT MATERIAL: 1 Neat cement 2 Cement grout 3 Bentonite 4 Other _____
 Grout Intervals: From 23 ft. to 0 ft., From _____ ft. to _____ ft., From _____ ft. to _____ ft.
 What is the nearest source of possible contamination:
 1 Septic tank 4 Lateral lines 7 Pit privy 10 Livestock pens 14 Abandoned water well
 2 Sewer lines 5 Cess pool 8 Sewage lagoon 11 Fuel storage 15 Oil well/Gas well
 3 Watertight sewer lines 6 Seepage pit 9 Feedyard 12 Fertilizer storage 16 Other (specify below) _____
 13 Insecticide storage _____
 Direction from well? _____ How many feet? _____

FROM	TO	LITHOLOGIC LOG	FROM	TO	PLUGGING INTERVALS
<u>60</u>	<u>23</u>	<u>Gravel</u>			
<u>23</u>	<u>0</u>	<u>Bentonite</u>			

7 CONTRACTOR'S OR LANDOWNER'S CERTIFICATION: This water well was (1) constructed (2) reconstructed or (3) plugged under my jurisdiction and was completed on (mo/day/year) 9-22-07 and this record is true to the best of my knowledge and belief. Kansas Water Well Contractor's License No. 426 This Water Well Record was completed on (mo/day/yr) 10-6-07 under the business name of TOWN & COUNTRY WATER WELL by (signature) Al Tzee

OFFICE USE ONLY T R EW SEC. 1/4 1/4 1/4